


TIN R I O W W M

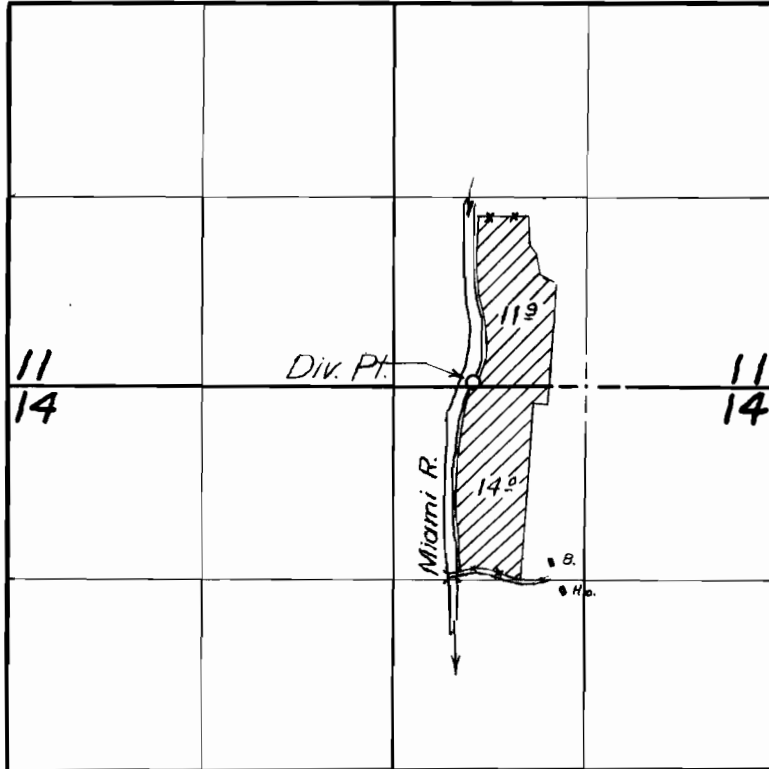

FINAL PROOF SURVEY
UNDER

Application No. 26682, Permit No. 20891
IN NAME OF

Cyril A. & Loretta Jacobs

Surveyed July 19, 1955, by *M. Bish*