


T. 4 S. R. 3 W. W. M.

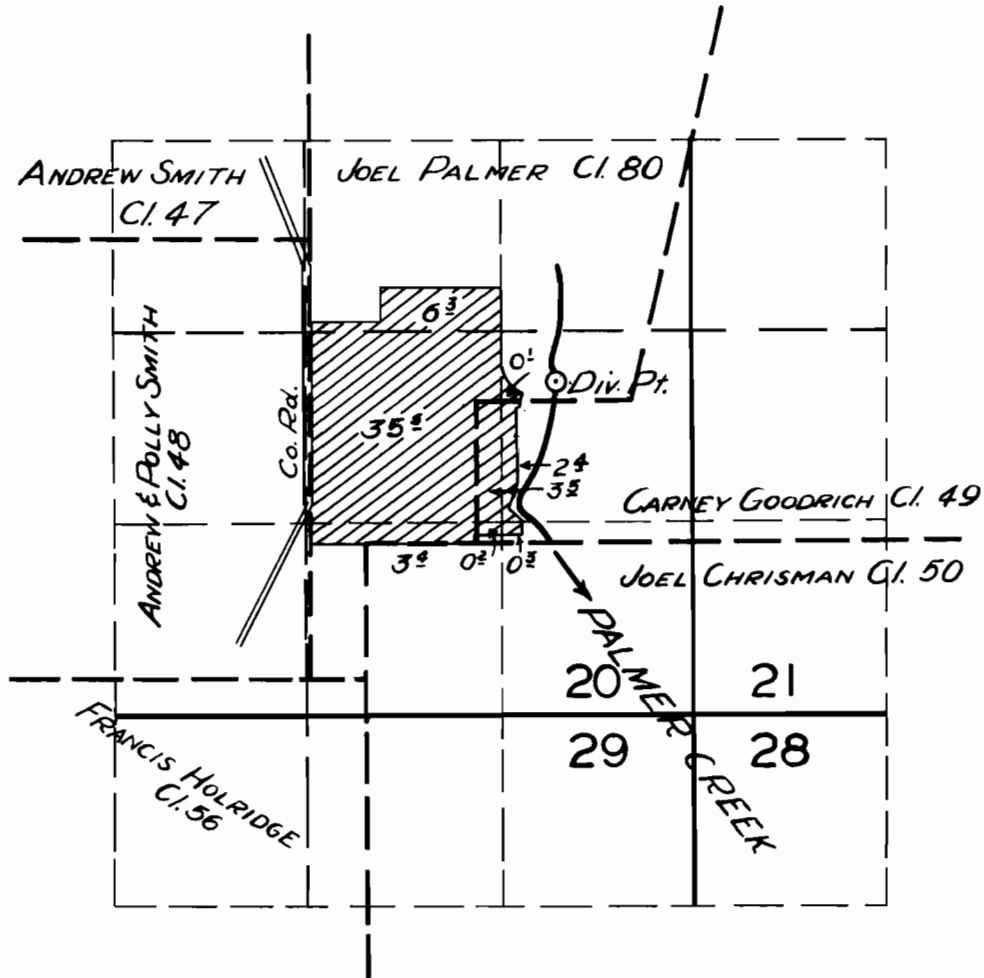

FINAL PROOF SURVEY

UNDER

Application No. 26730 Permit No. 20919

IN NAME OF

GLEN & ETHEL CHILDS

Surveyed 19 Sep. 1955, by

DFQ 5D-28