


T6SR10WWM

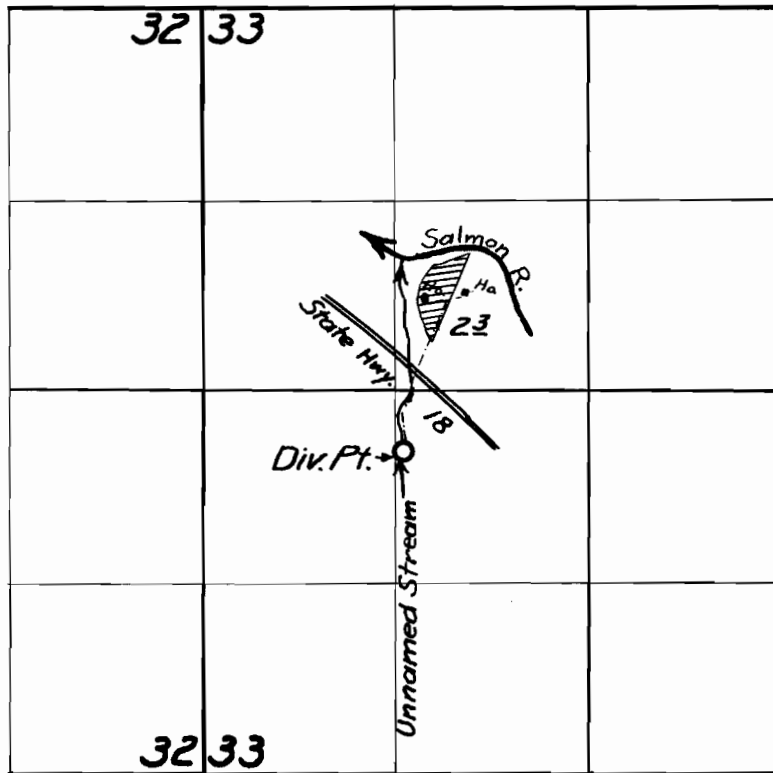

FINAL PROOF SURVEY

UNDER

Application No. 21282 Permit No. 16675

IN NAME OF

Harry Bradley & Percy Calkins

Surveyed Aug 30 1955, by M. G. Sisk