



Range 24 E.W.M.

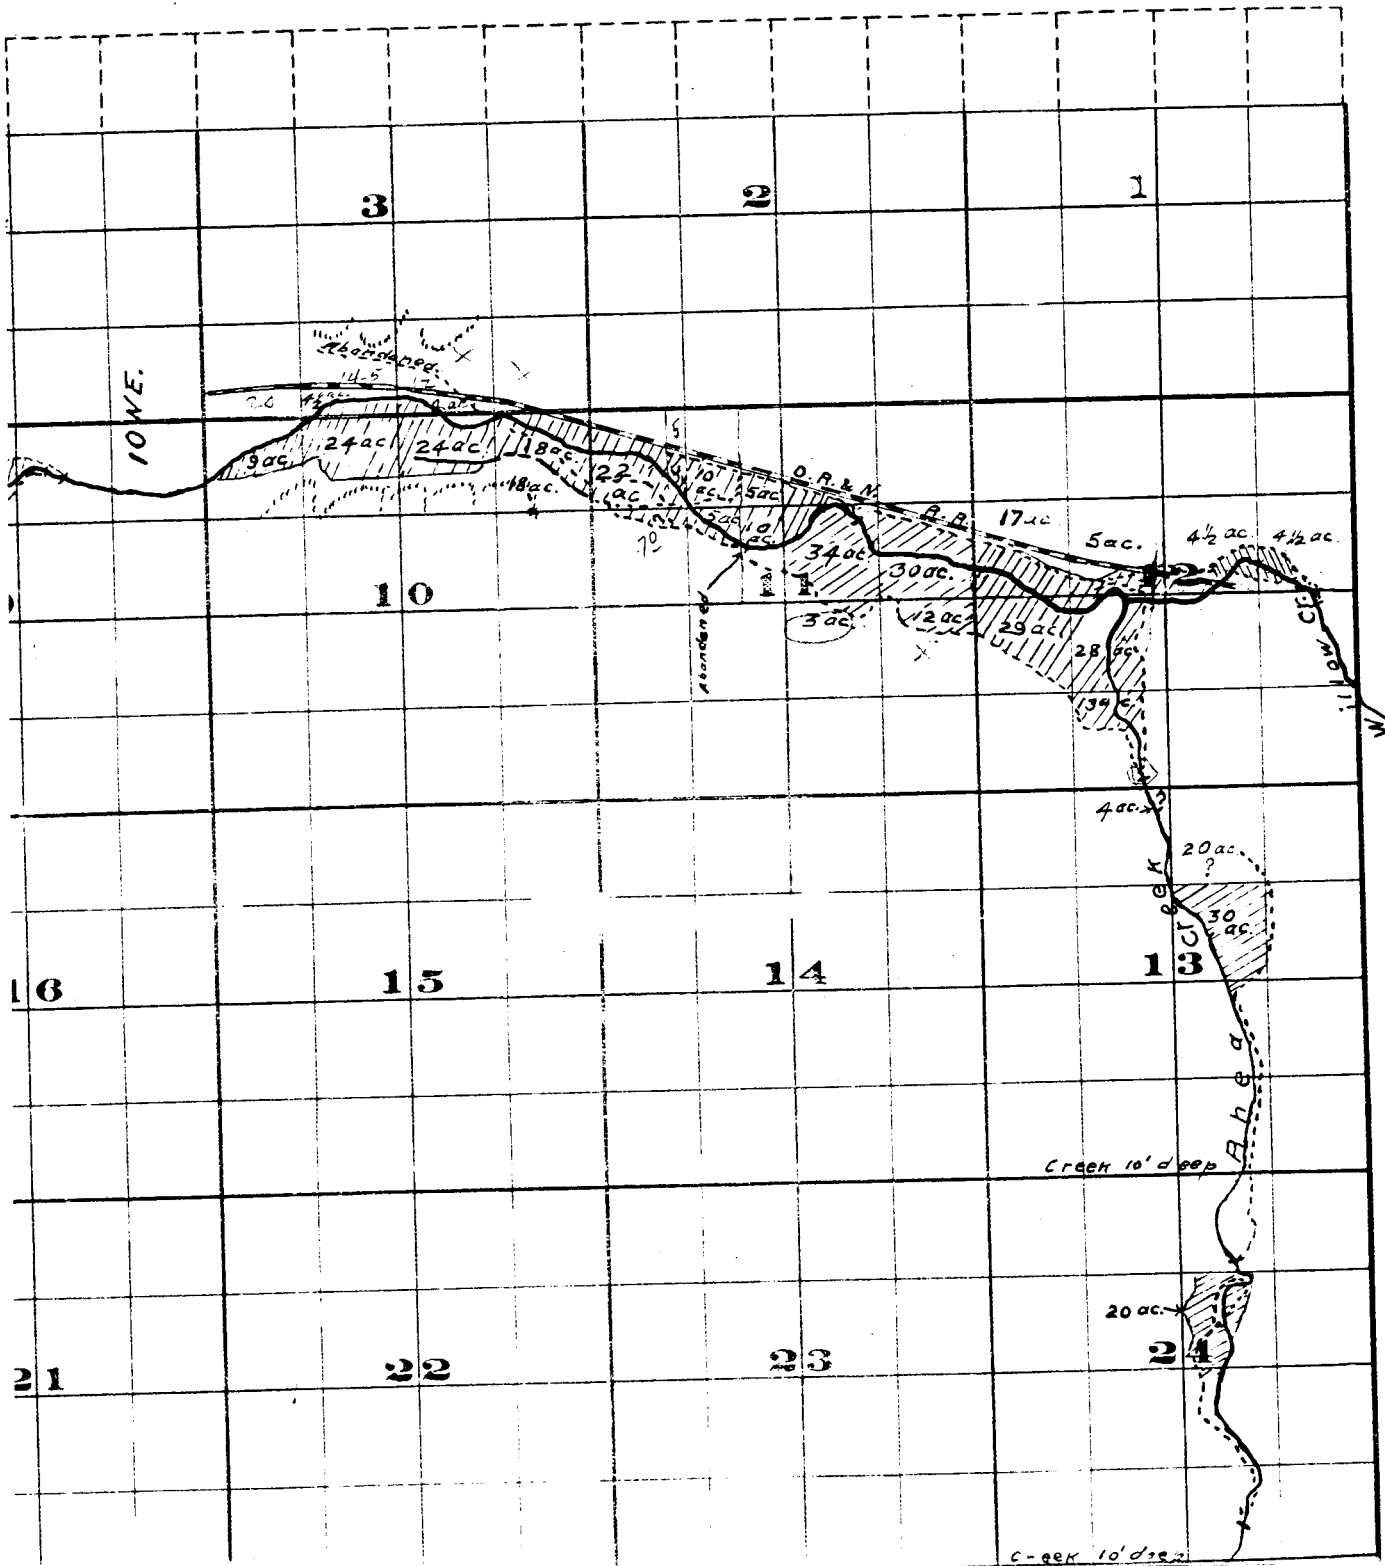

Township 15.

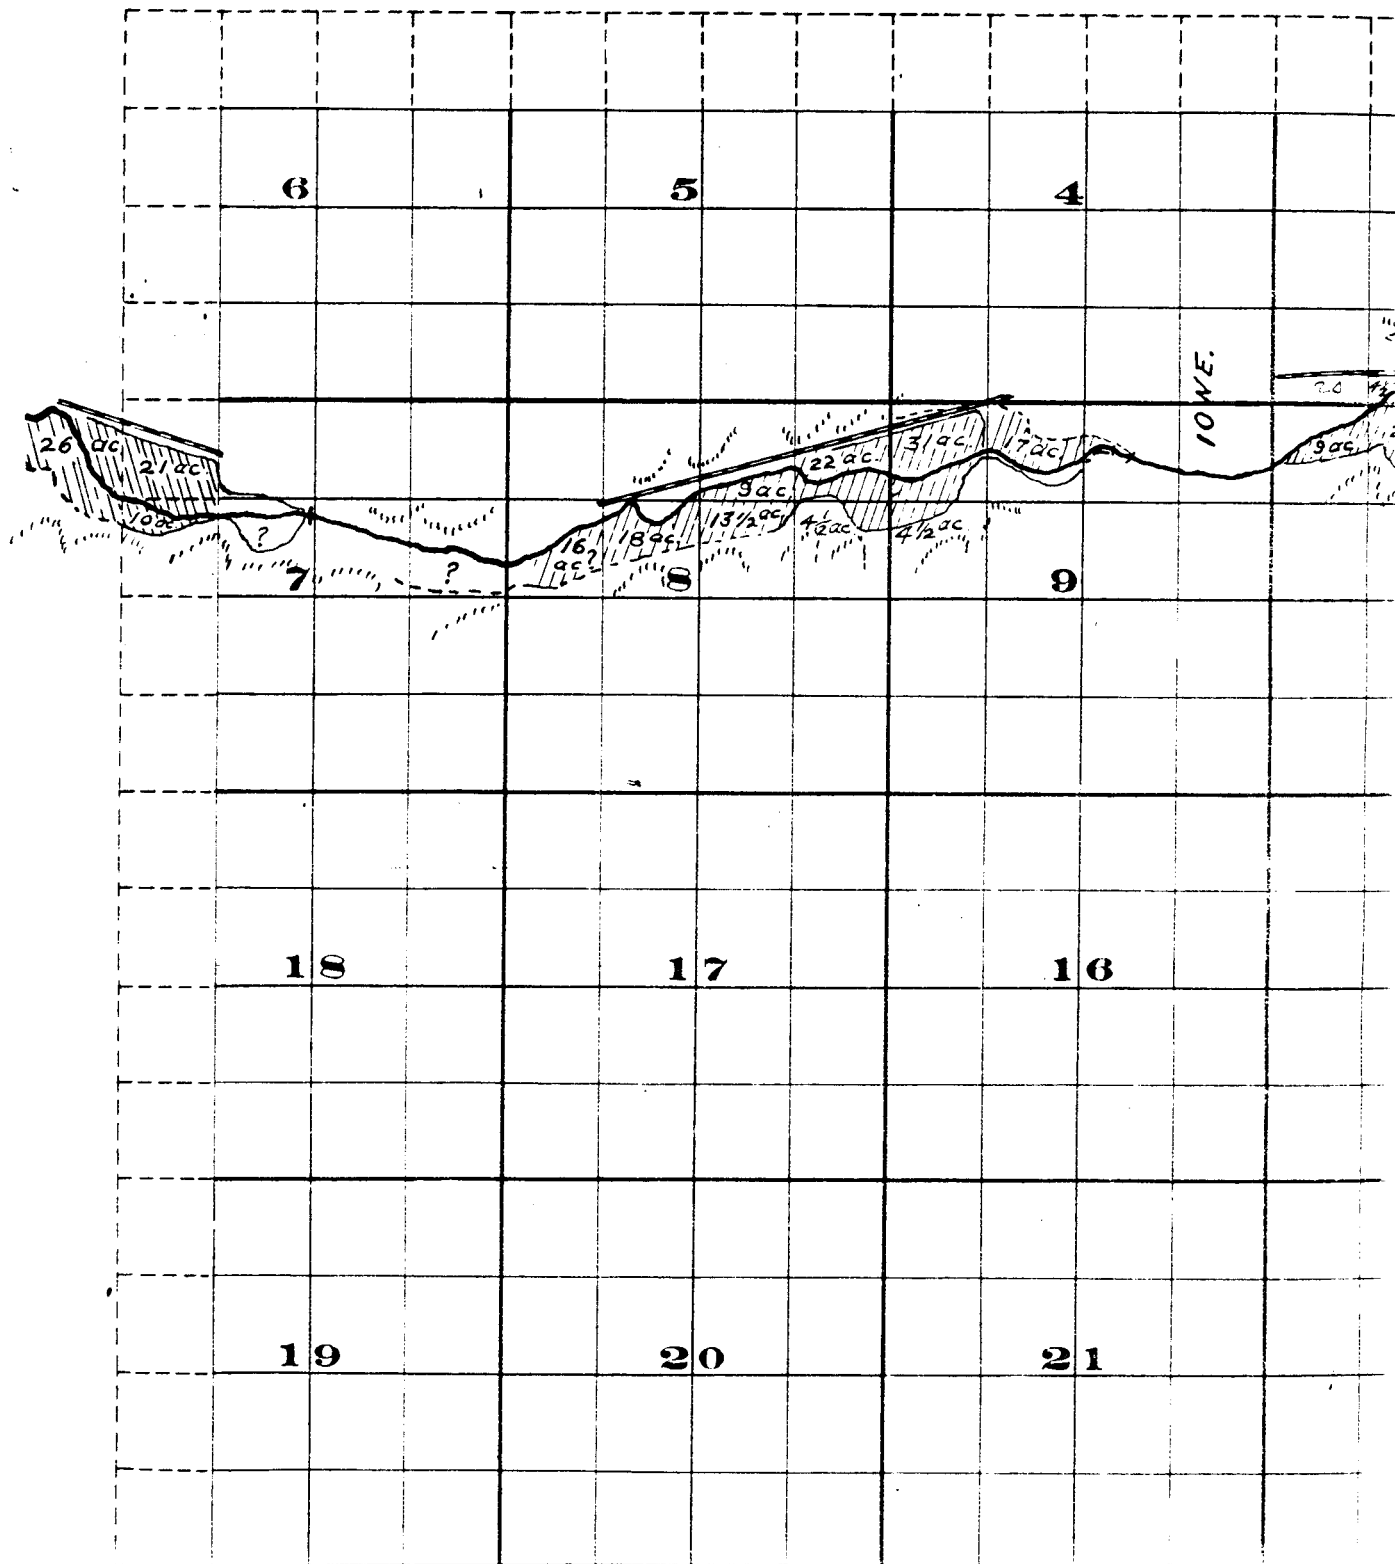

18

17

16

15

19

20

21

22

30

29

28

27

31

32


33

34

Surveyed by R.D. Cooper July 1909

John H. Lewis - State Engineer

Examined July 14, 1909.

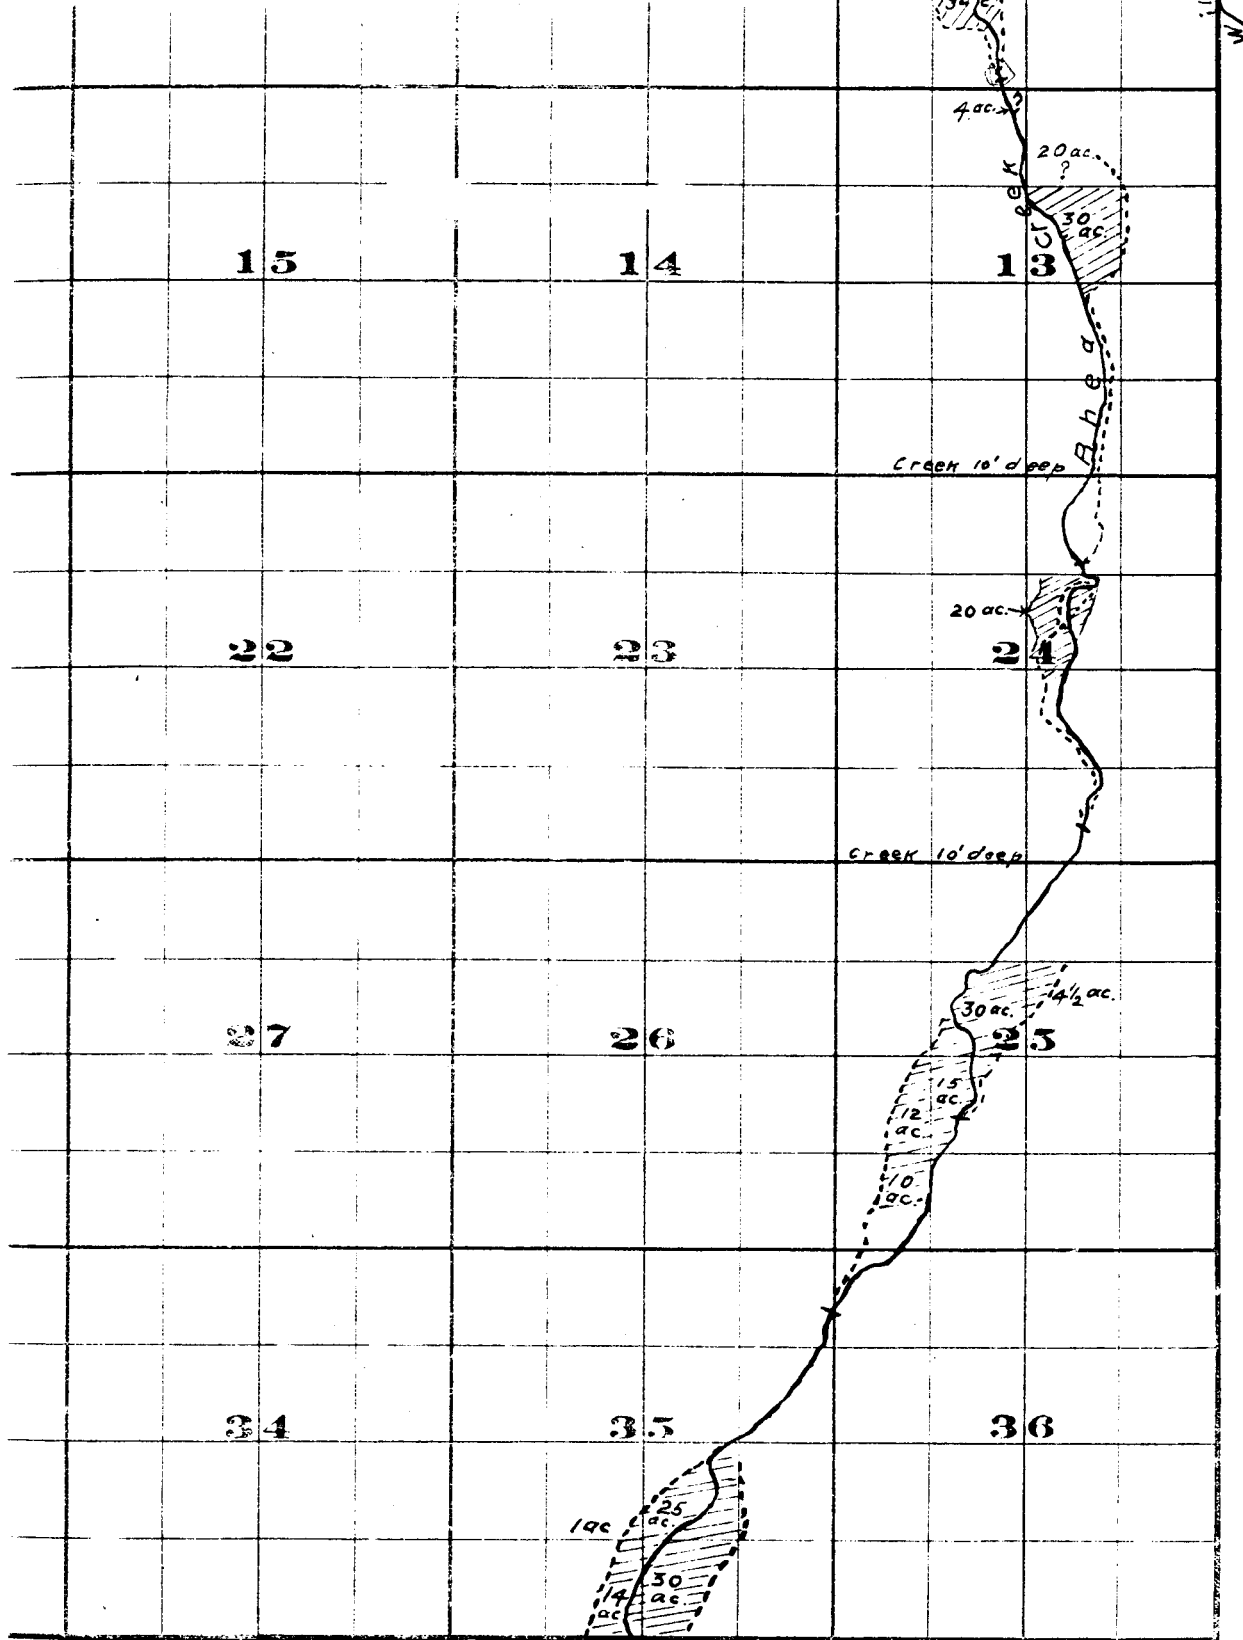


FROM OFFICE OF THE STATE ENGINEER, SALEM, OREGON

Willow Creek Adjudication.

1 S. 24 E

R. 1 E. 37 E

Range 24 E.W.M.

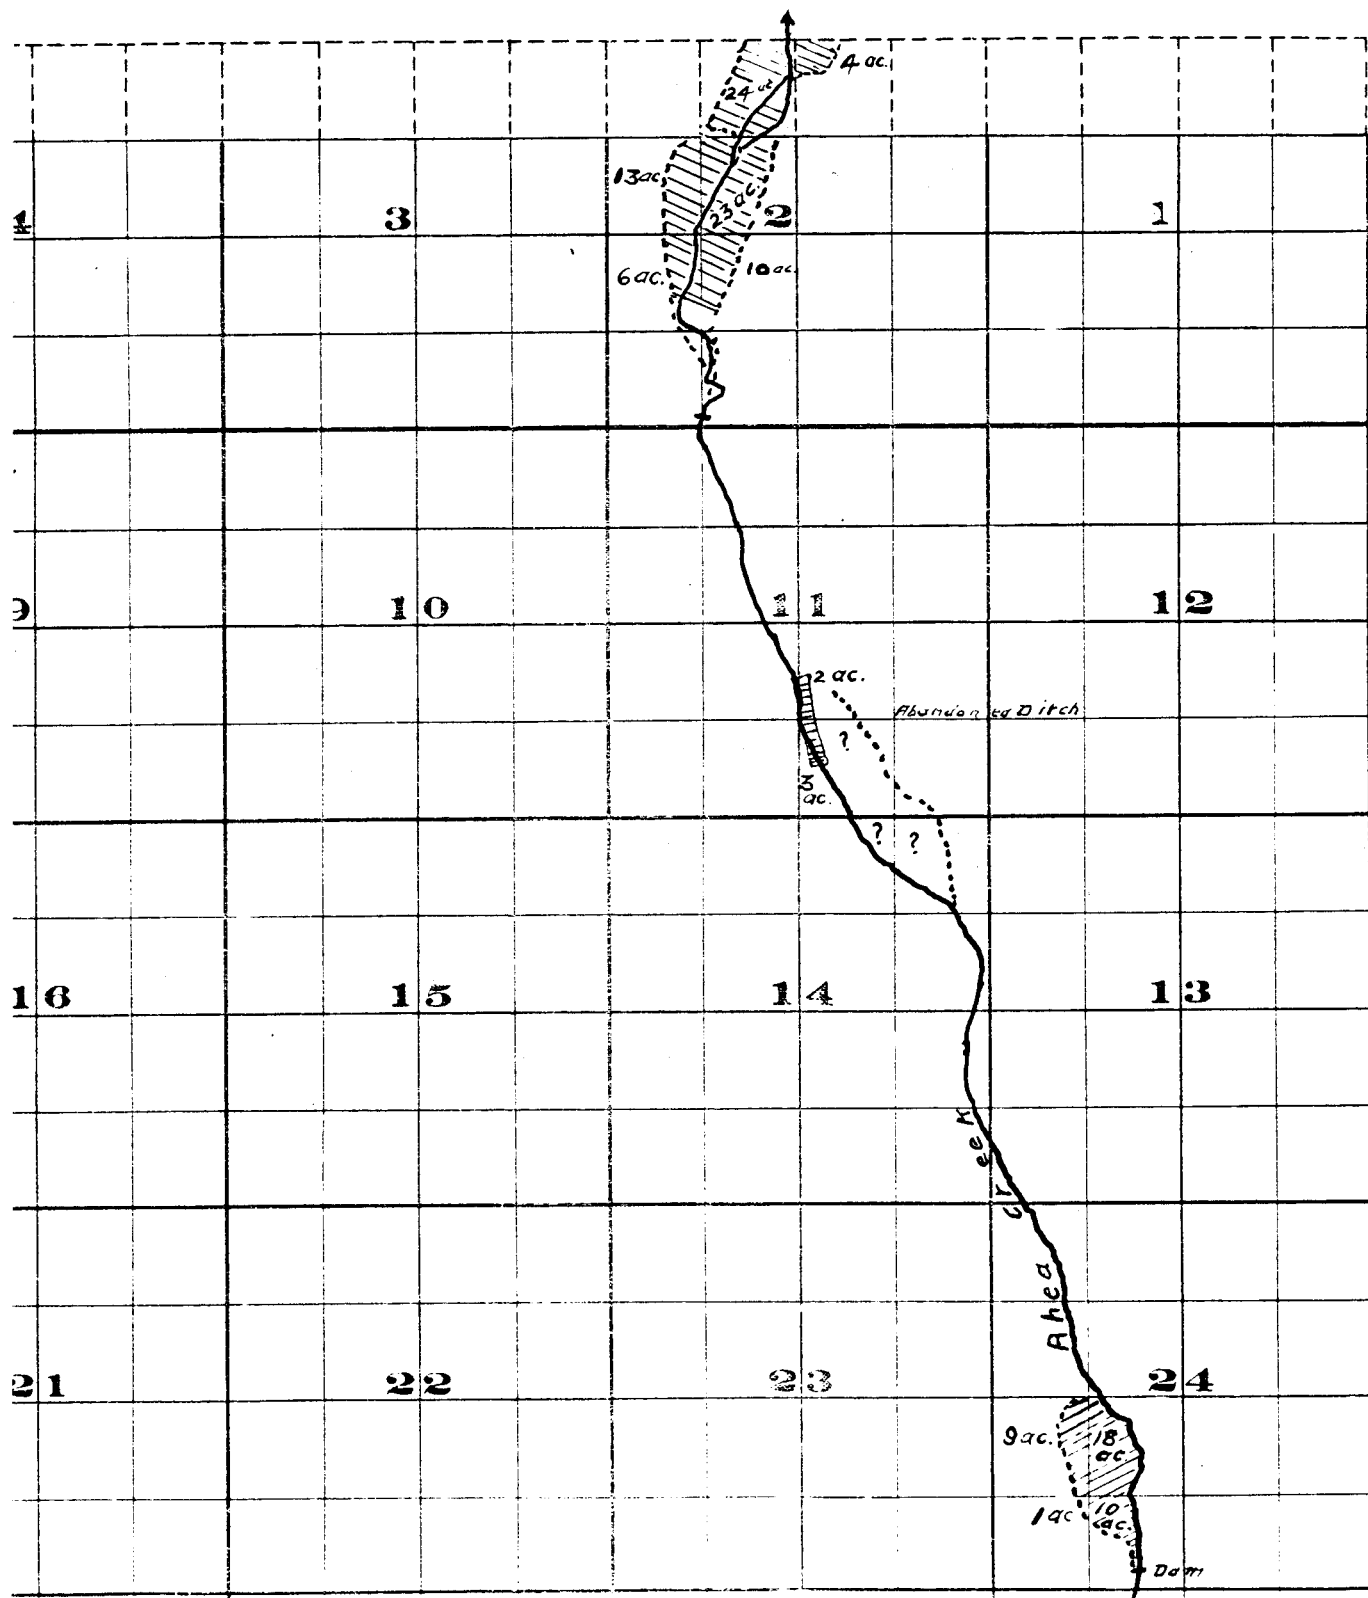


7		8		9		10
18		17		16		15
19		20		21		22
30		29		28		27
31		32		33		34

THIS IS A REPRODUCED COPY OF THE ORIGINAL RECORD.

Surveyed by R.D. Cooper July 1909

John H. Lewis - State Engineer.

Examined July 14, 1909.

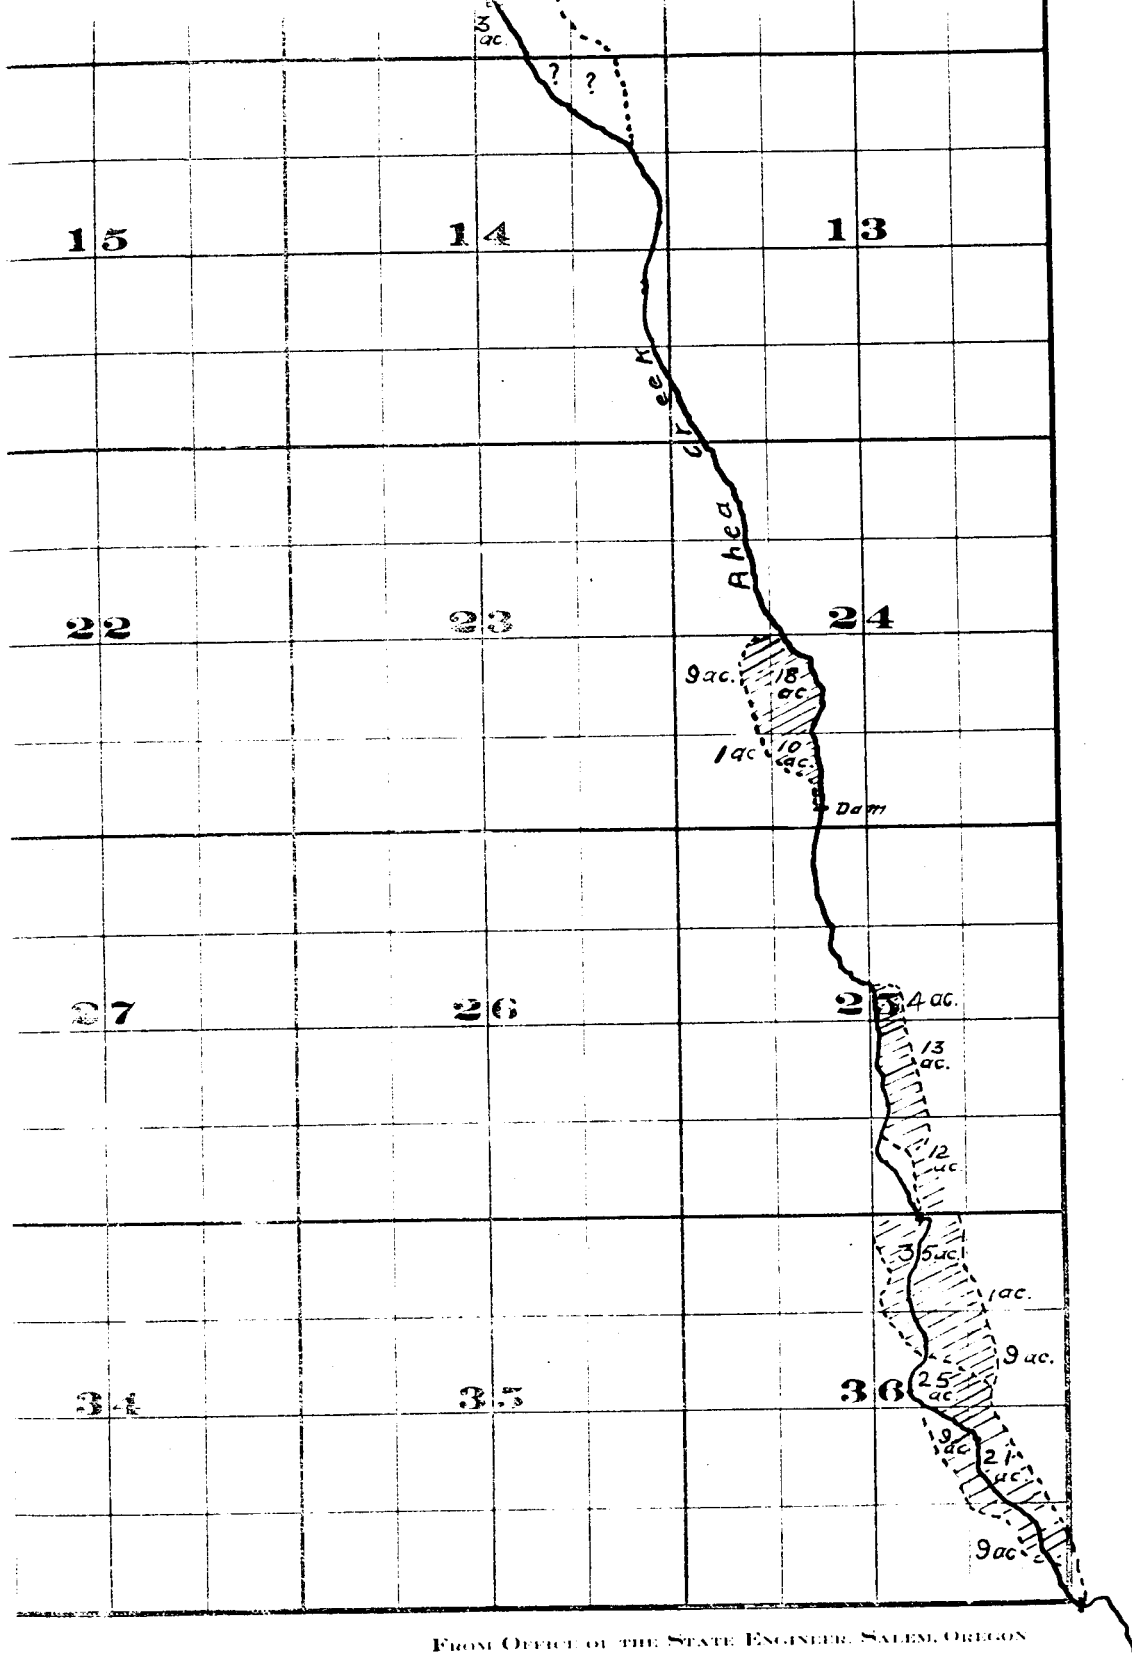

FROM OFFICE OF THE STATE ENGINEER, SALEM, OREGON

Willow Creek Adjudication.

2 S. 24 E.