


T.2S.R.9W.W.M.

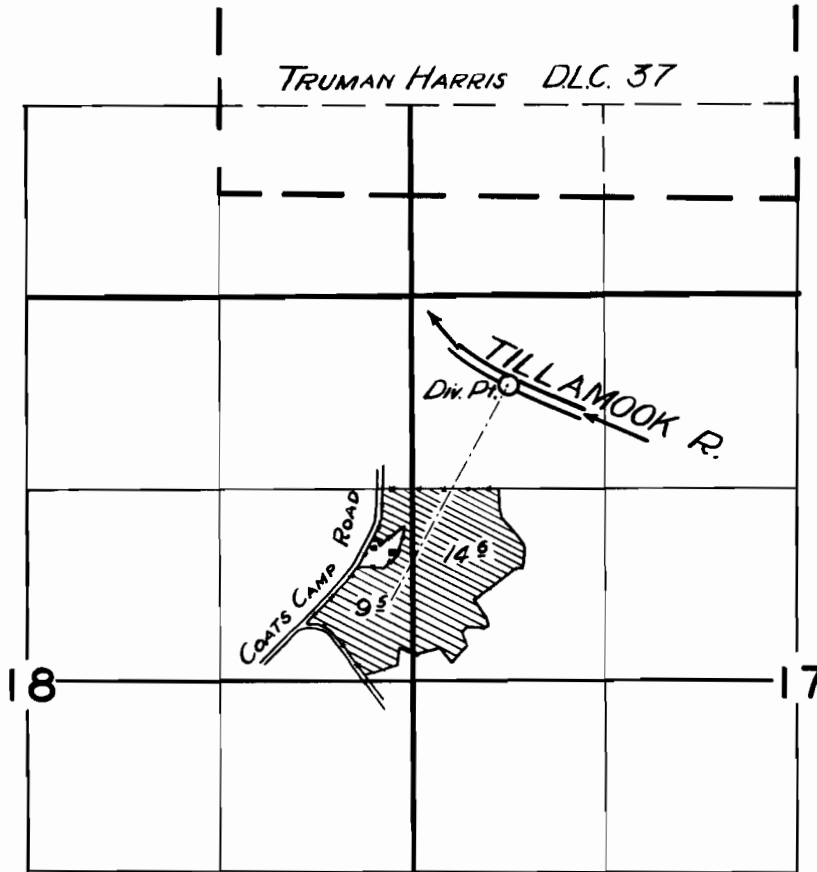

FINAL PROOF SURVEY

UNDER

Application No. 26788 Permit No. 20941

IN NAME OF

CARL L. RAWE

Surveyed 6 Sep. 1955, by *A. Whitty*

1955-E