


T1&2SR9WWM

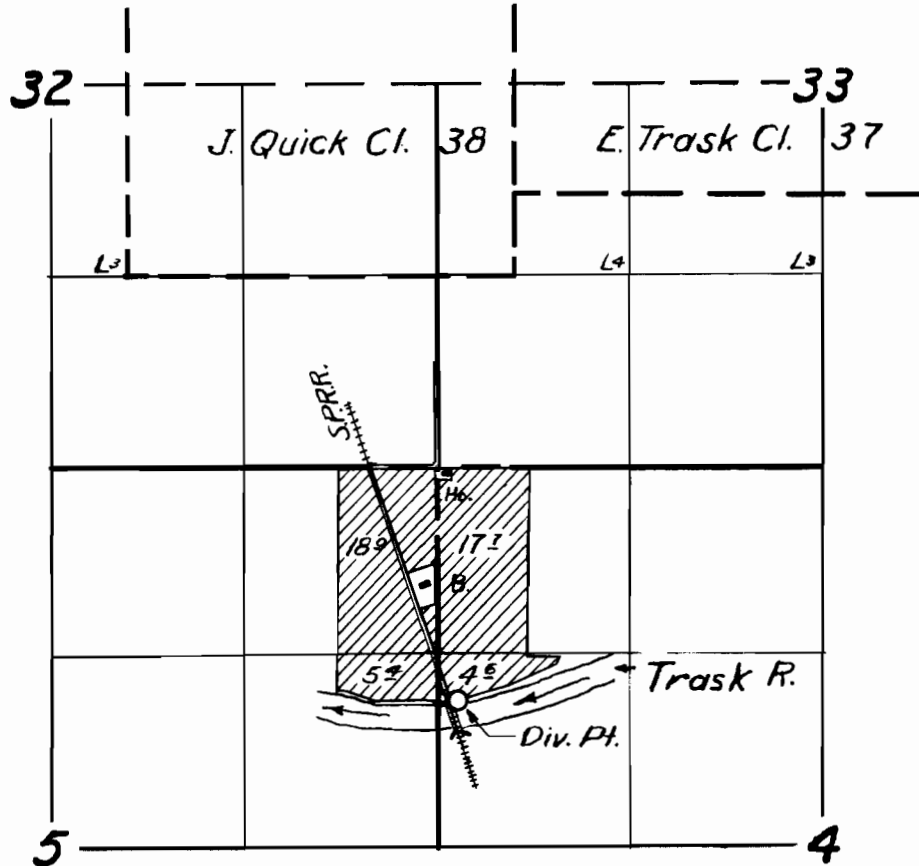

FINAL PROOF SURVEY

UNDER

Application No. 26815 Permit No. 21058

IN NAME OF

FRITZ SCHRANZ

Surveyed July 21 1955, by M. Bish

1955L