


T.19 & 20 S.R.47 E.W.M.

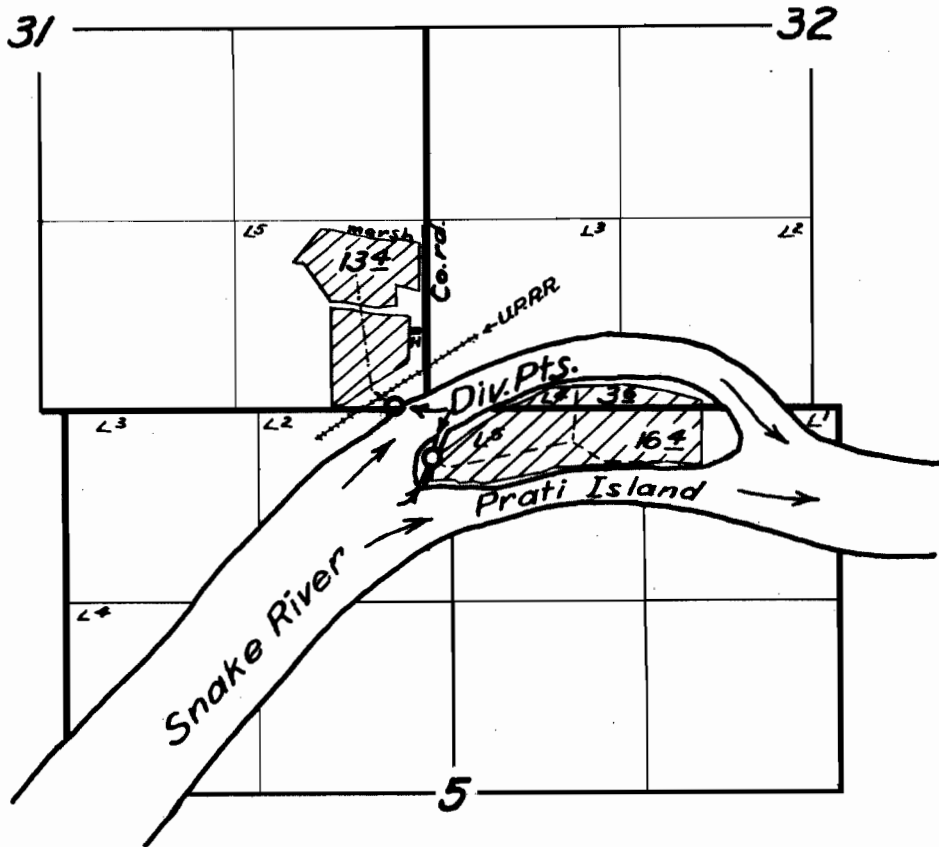

FINAL PROOF SURVEY

UNDER

Application No. 26886 Permit No. 21128

IN NAME OF

J. Melvin Beck

Surveyed Oct. 13 1955, by Tr. Bish