


T.4S.R.10W.W.M.

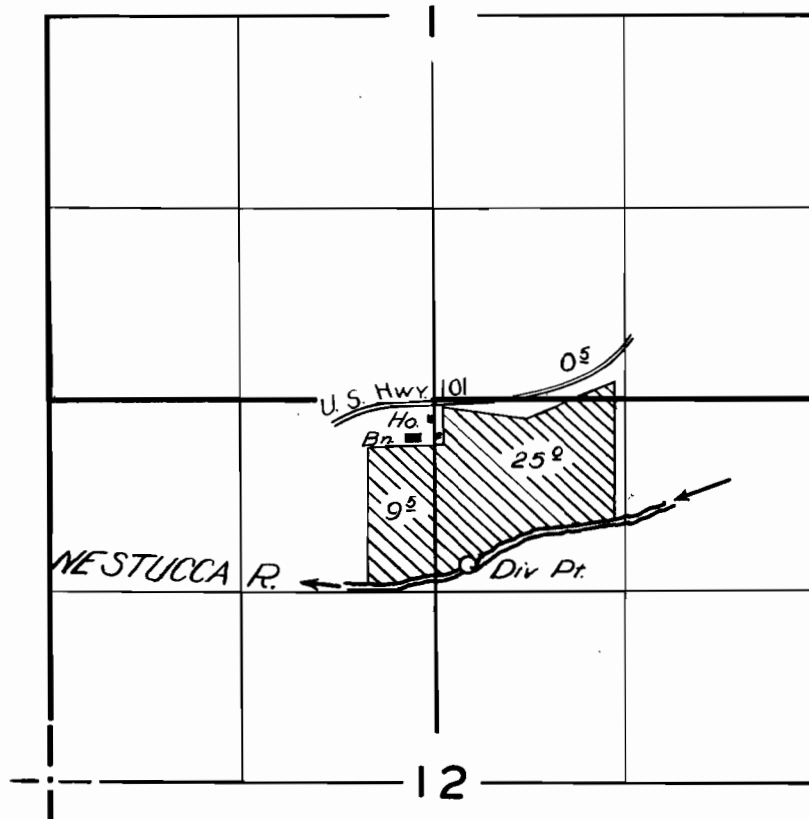

FINAL PROOF SURVEY
UNDER

Application No. 26927 Permit No. 21158

IN NAME OF
EGBERT J. & EDNA CLAUSSEN
ARNOLD & ELSIE GRUENWALD

Surveyed 25 Aug 1955, by *J. A. Whitby*