


T1&2SR9WWM

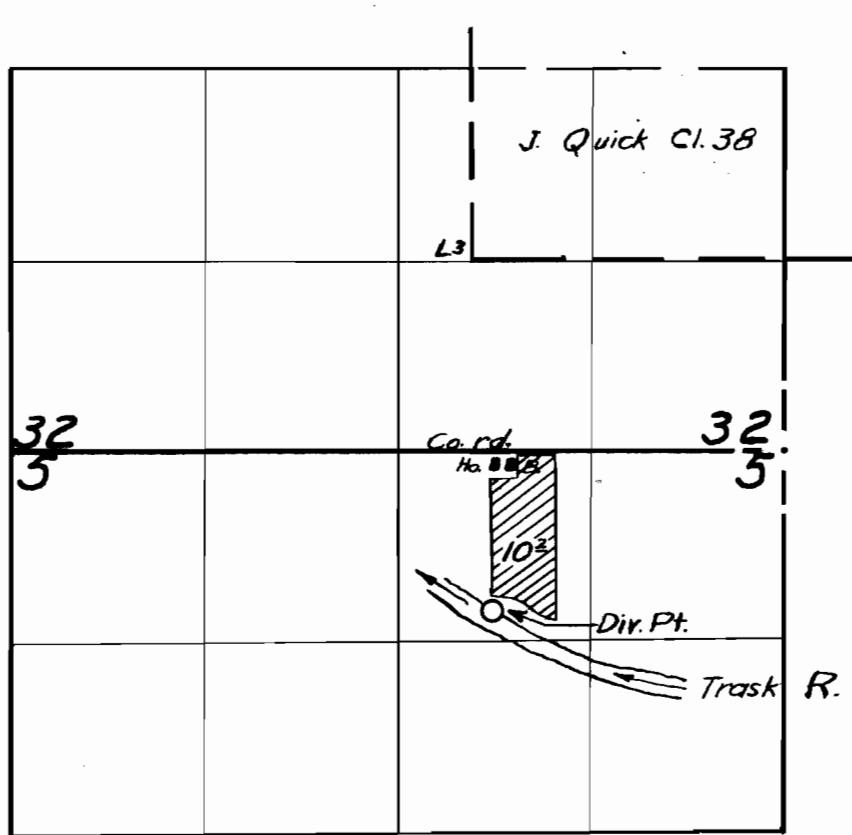

FINAL PROOF SURVEY

UNDER

Application No. 26857 Permit No. 21261

IN NAME OF

Andrew & Katharina Thoeni

Surveyed July 22 1955, by *M. Bishop*