


T. 1 S. R. 21 E. W. M.

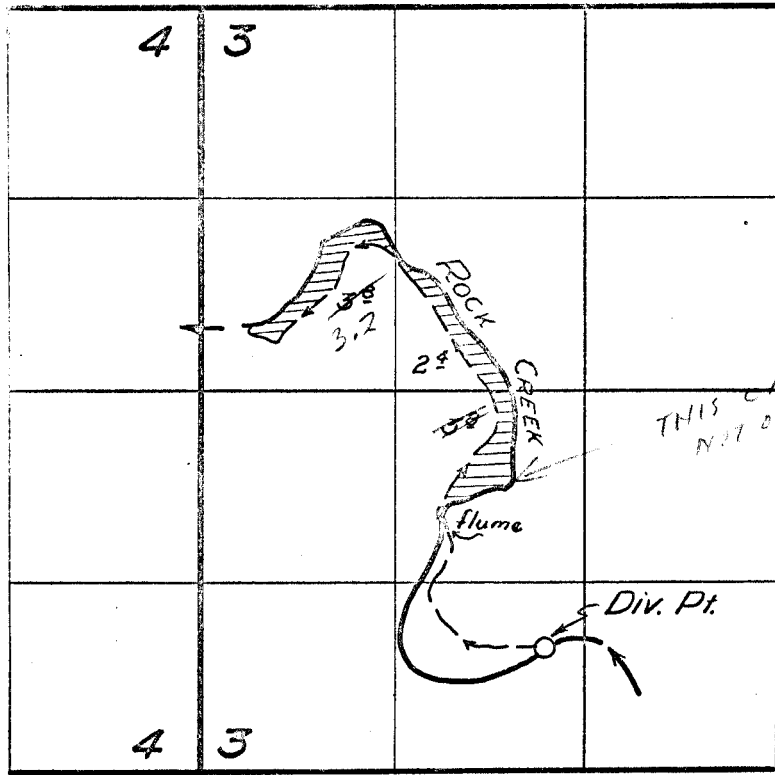

FINAL PROOF SURVEY
UNDER

Application No. 27077 Permit No. 21305
IN NAME OF

R. E. IRBY

Surveyed 14 April 1955, by T. JONES