


T.1N.R.48E.W.M.

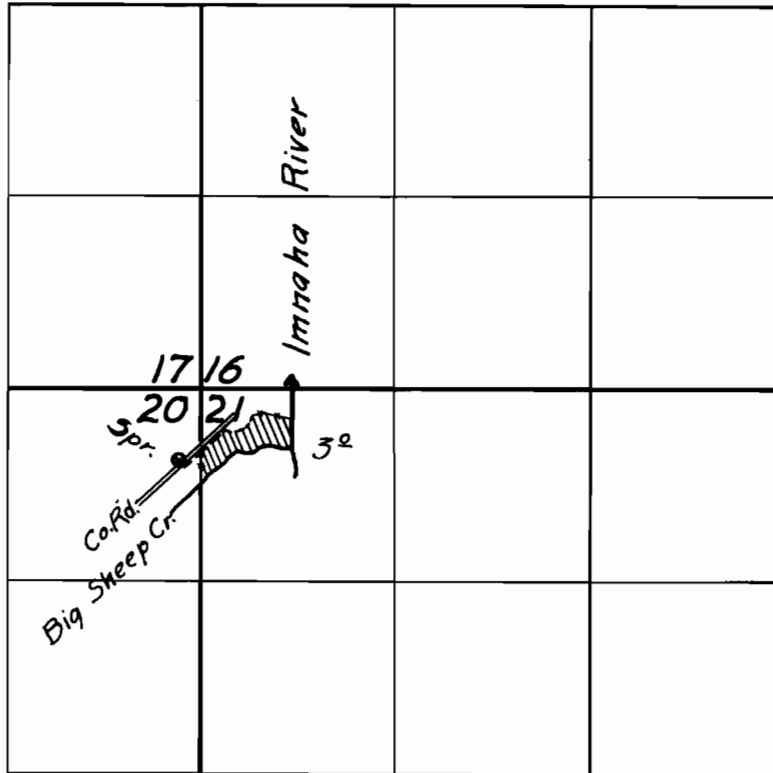

FINAL PROOF SURVEY

UNDER

Application No. 27114 Permit No. 21331

IN NAME OF

ERNEST L. COOTS

Surveyed 19 October 1955, by Robert [Signature]