


T. 1 S. R. 9 W. W.M.

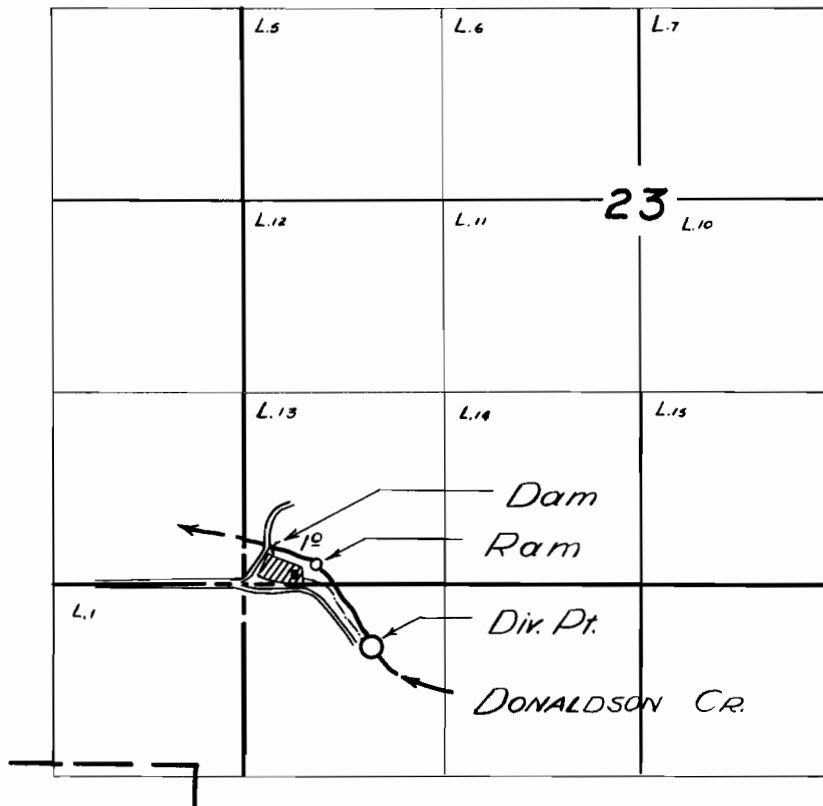

FINAL PROOF SURVEY
UNDER

Application No. *27239* Permit No. *21432*
IN NAME OF

LOUISE B. & WARREN A. McMINIMEE

Surveyed *12 July 1955*, by *T. JONES*

1955-Z