


T. 4 S. R. 10 W. W. M.

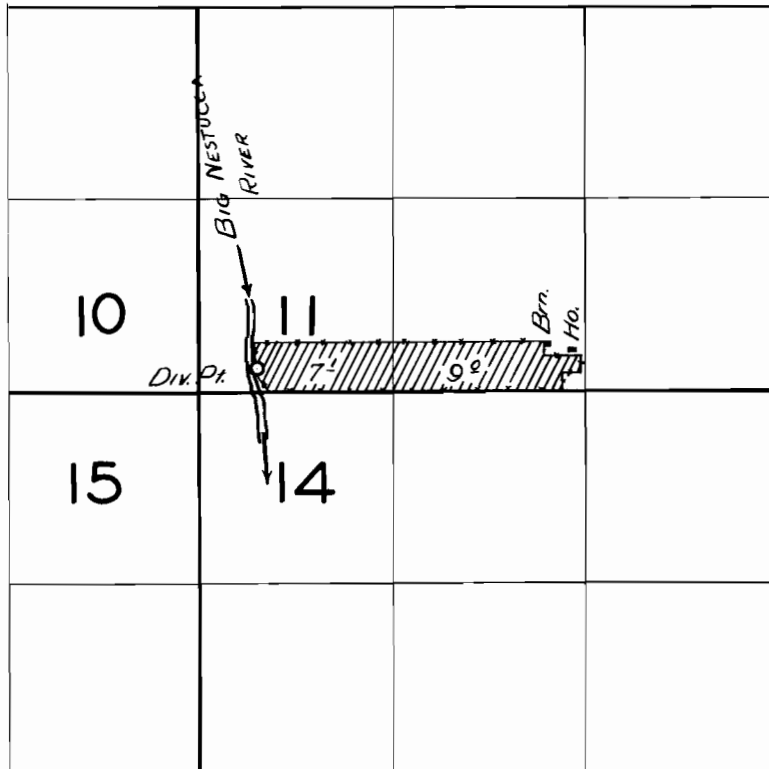

FINAL PROOF SURVEY

UNDER

Application No. 27294 Permit No. 21468

IN NAME OF

CLYDE LANE

Surveyed 11 Aug 1955, by *[Signature]*