


T.28S. R.10W. WM

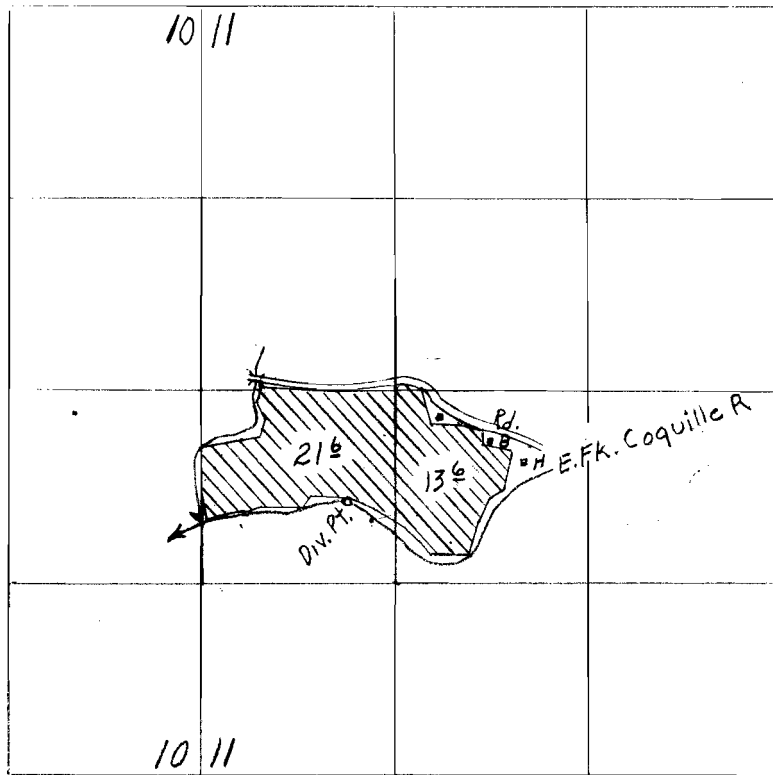

FINAL PROOF SURVEY
Under

Application 27374 Permit 21549
In name of
Elmer Wilson

Surveyed Mar 20 1955 by T. Jones