


T.16 S.R.47 & 48 E.W.M.

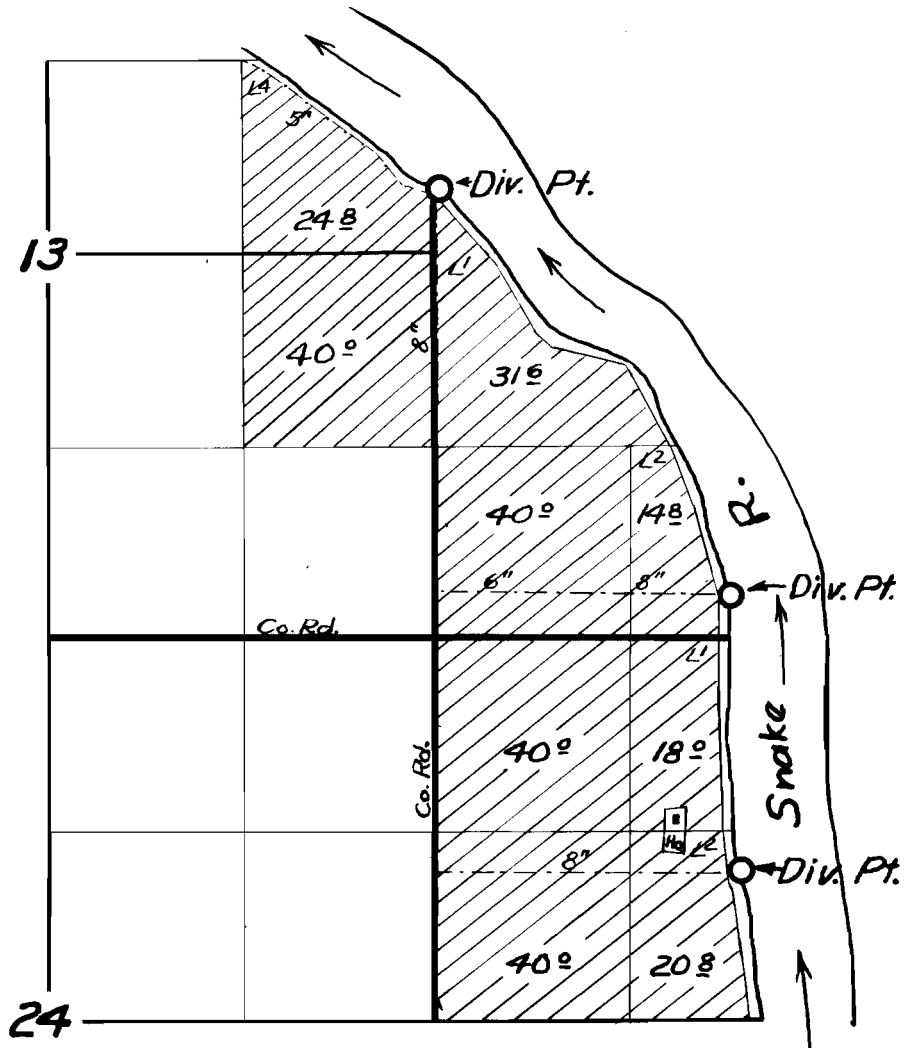

**FINAL PROOF SURVEY**

UNDER

Application No. 25506. Permit No. 21572.

IN NAME OF

*Theodore and/or Orida L. Reins*

Surveyed Oct. 31, 1955, by *M. B. Rich*