


T.19S.R.47E.W.M.

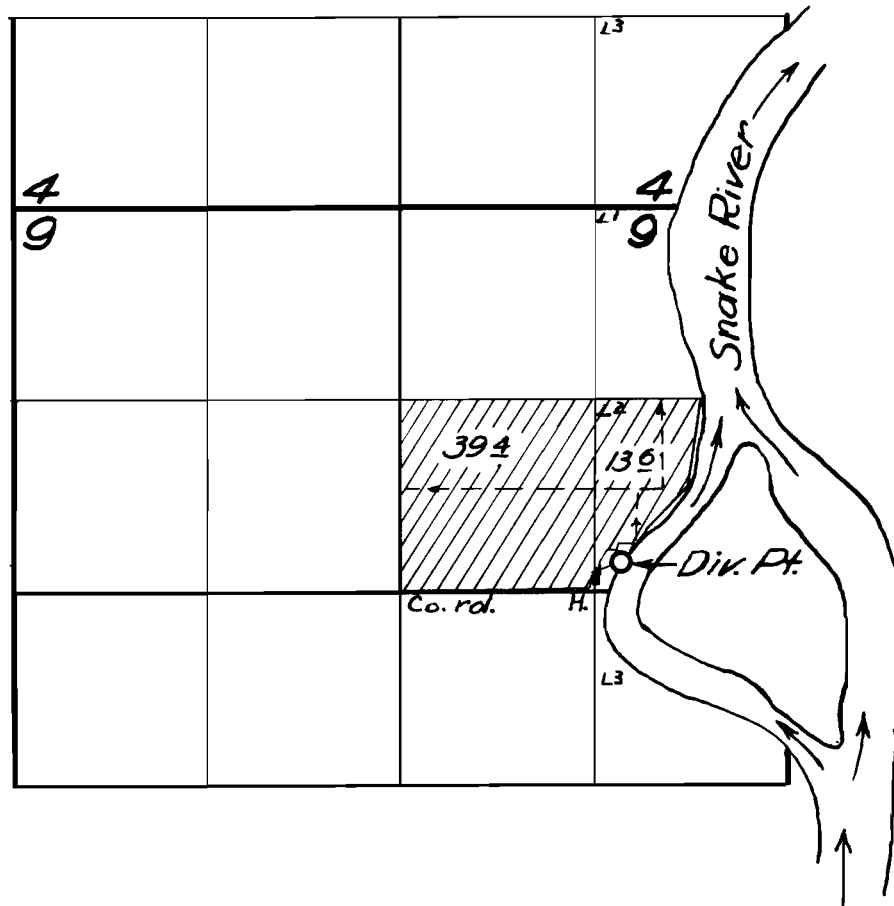

FINAL PROOF SURVEY

UNDER

Application No. 27439 Permit No. 21603

IN NAME OF

Henry Lissman

Surveyed Oct. 14 1955 by M. Bush

1955N