


T. 13S. R. 33E. W.M.

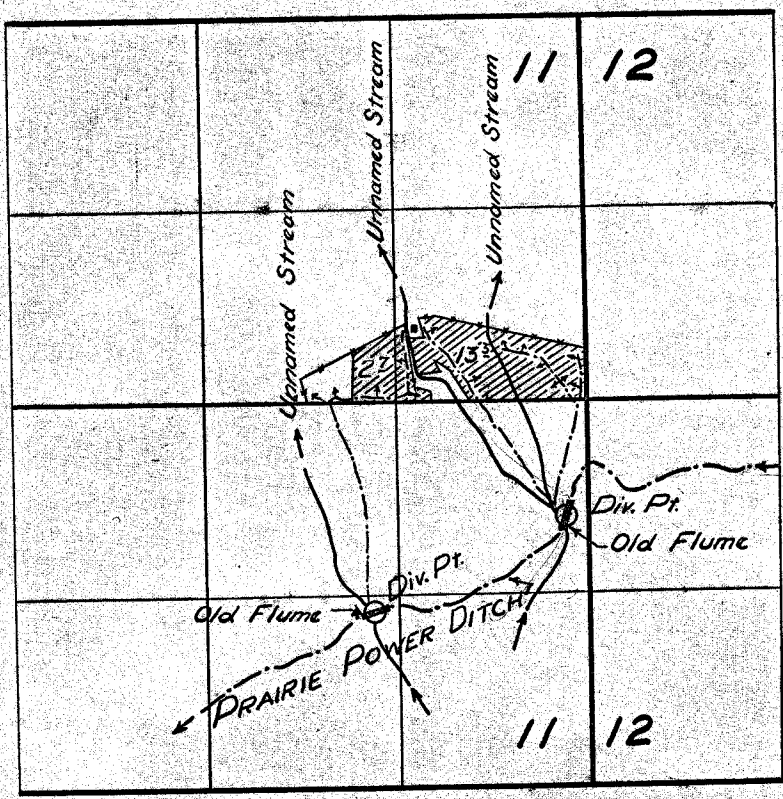

FINAL PROOF SURVEY
UNDER

Application No. 27715 Permit No. 21814
IN NAME OF

FRED A. DEARDORFF

Surveyed 19 Oct. 1955, by [Signature]