


T. 3 S. R. 10 W. W. M.

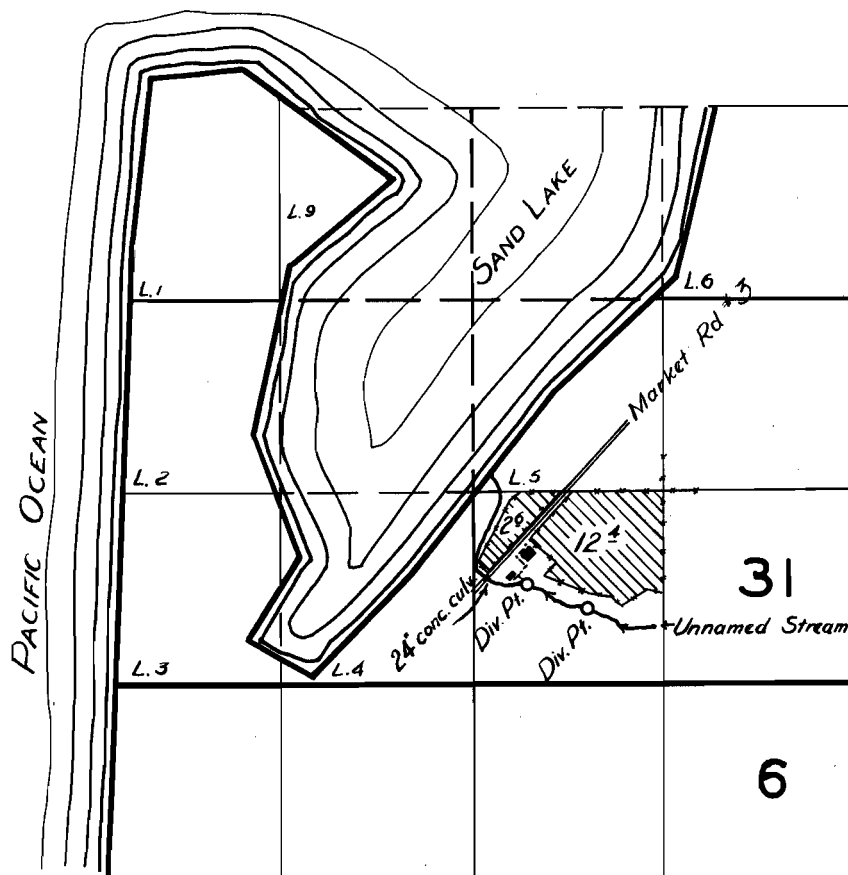

**FINAL PROOF SURVEY**

UNDER

Application No. 27719 Permit No. 21816

IN NAME OF

F. A. BELTZ

Surveyed 11 Aug. 1955, by *R. Whitley*