


T.17S.R.47E.W.M.

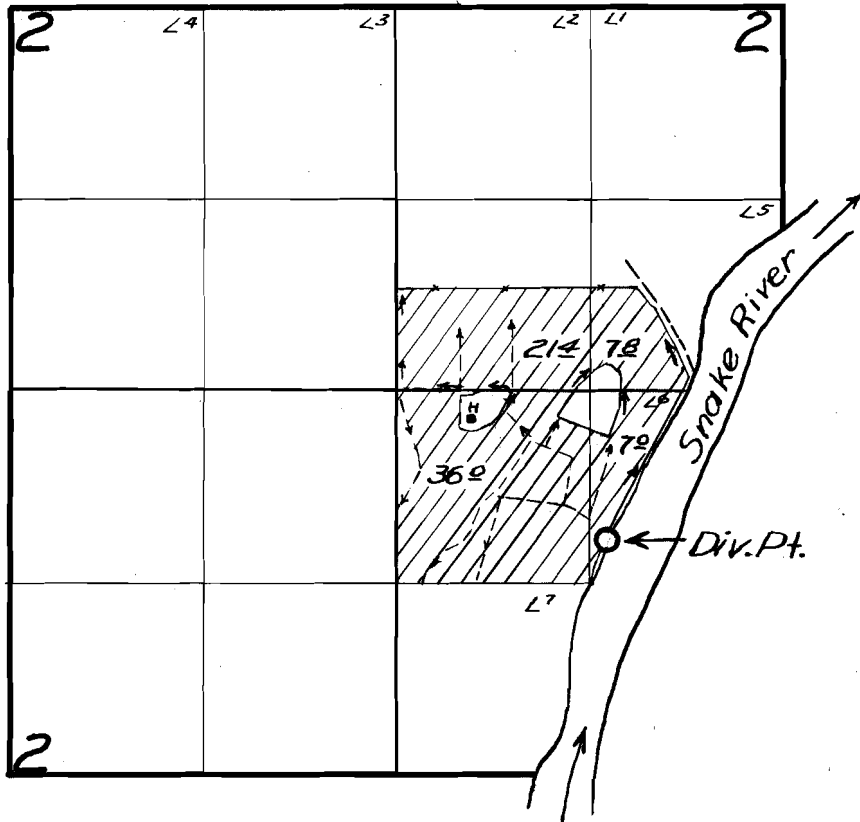

FINAL PROOF SURVEY

UNDER

Application No. 27781 Permit No. 21870

IN NAME OF

Harry Franklin Allen

Surveyed Oct. 10 1955, by Tm. Bush

1955N