


T15R9WWM

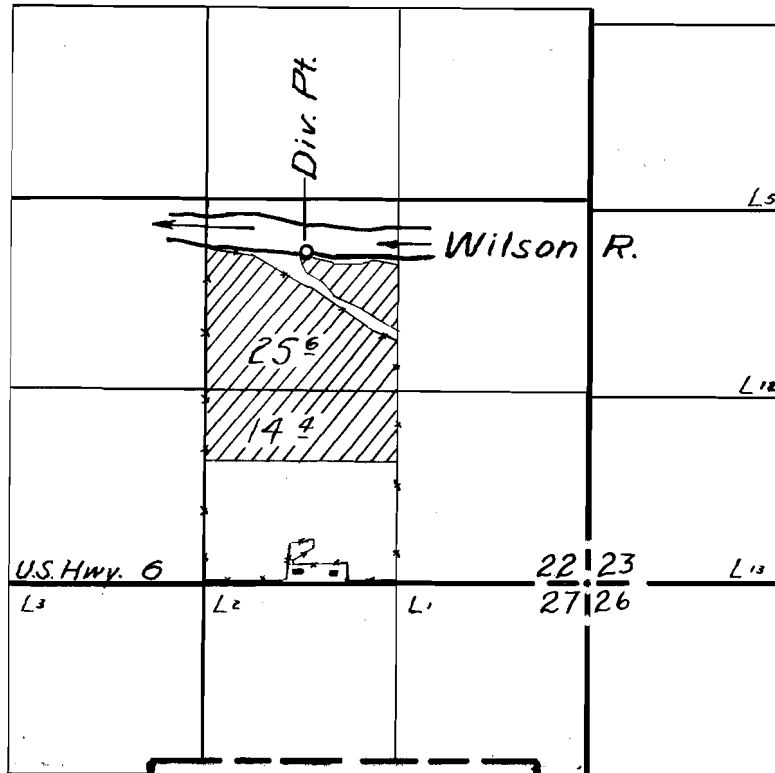

J. Champion Cl. 39

FINAL PROOF SURVEY

UNDER

Application No. 27856 Permit No. 21905
IN NAME OF

CHARLES B. SWANSON

Surveyed July 12 1955, by M. Bisha