


T. 4 S. R. 4 W. W.M.

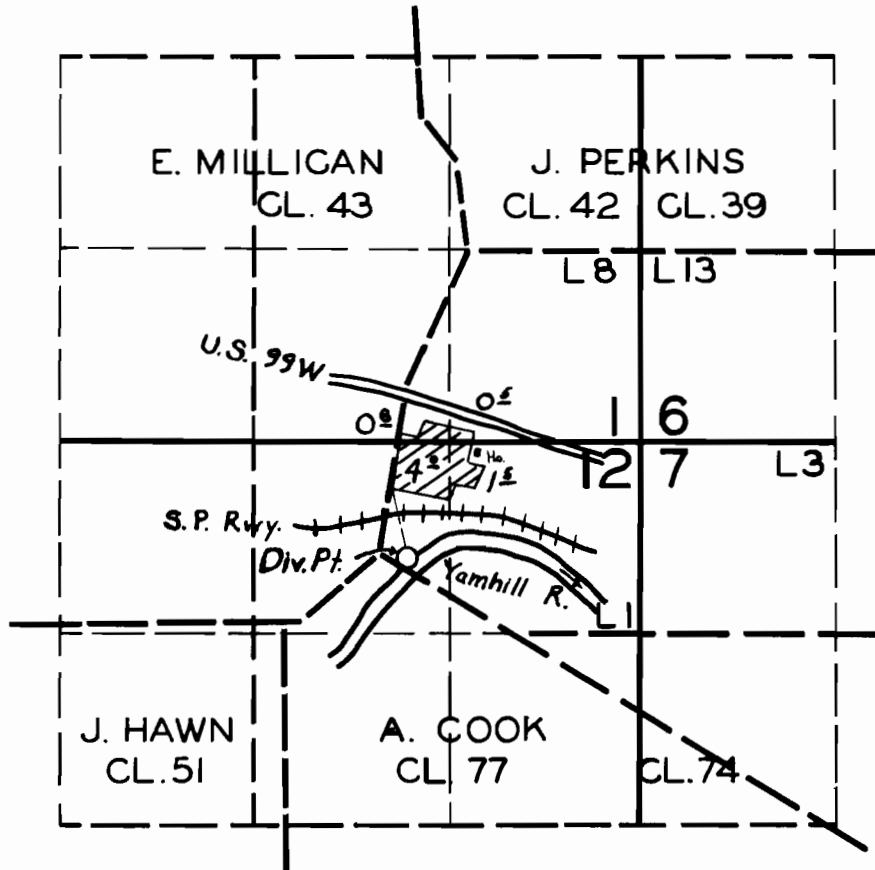

FINAL PROOF SURVEY
UNDER

Application No. 28032 Permit No. 22056
IN NAME OF

JOHN W. HATHAWAY

Surveyed JUNE 1955, by T. JONES

DFQ - 3D - 166