


T.11S., R. 8 & 9 W.W.M.

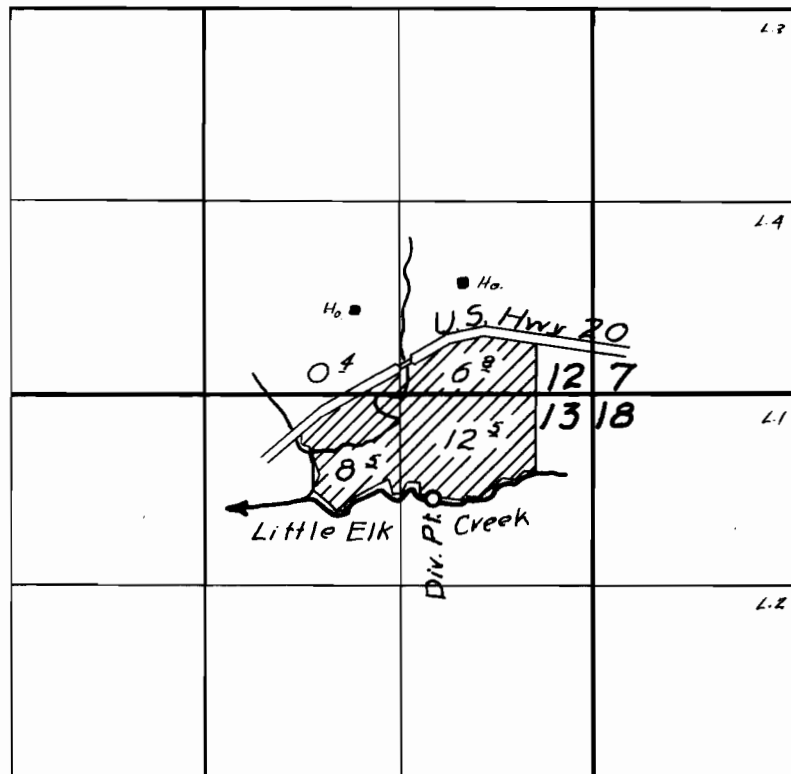

FINAL PROOF SURVEY
UNDER

Application No. 28099 Permit No. 22122
IN NAME OF

W.F. & B.H. WAKEFIELD

Surveyed 24 April 1955, by H.L. Coffman

1955 A.

1009