


T.14 S. R. 9 W. W.M.

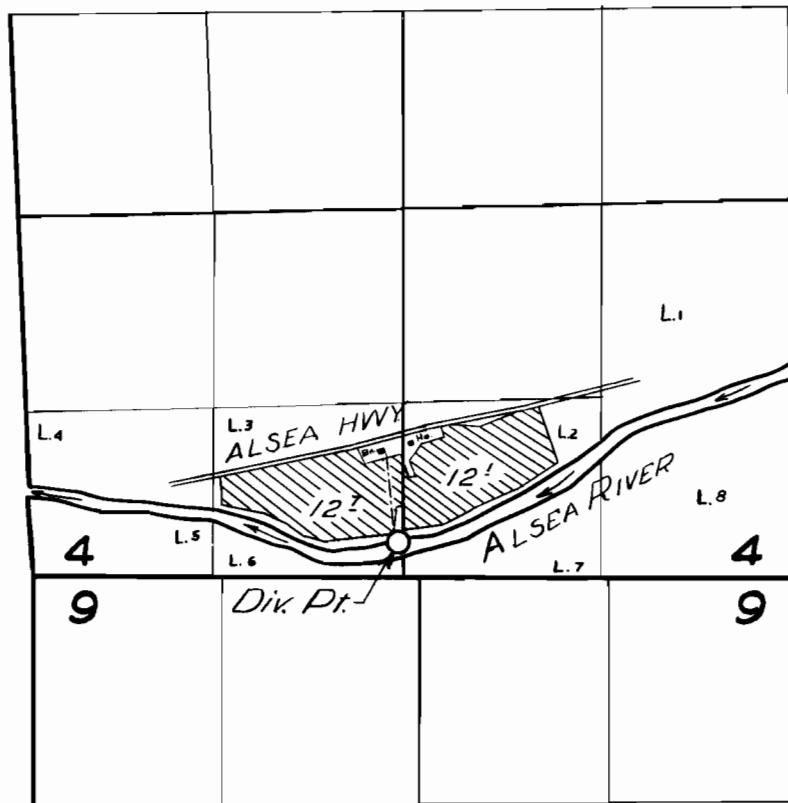

FINAL PROOF SURVEY
UNDER

Application No. 28131 Permit No. 22143
IN NAME OF

PAUL & ALICE RASSMUSSEN

Surveyed 25 JUNE 1955, by T. JONES