


T15R9WWM

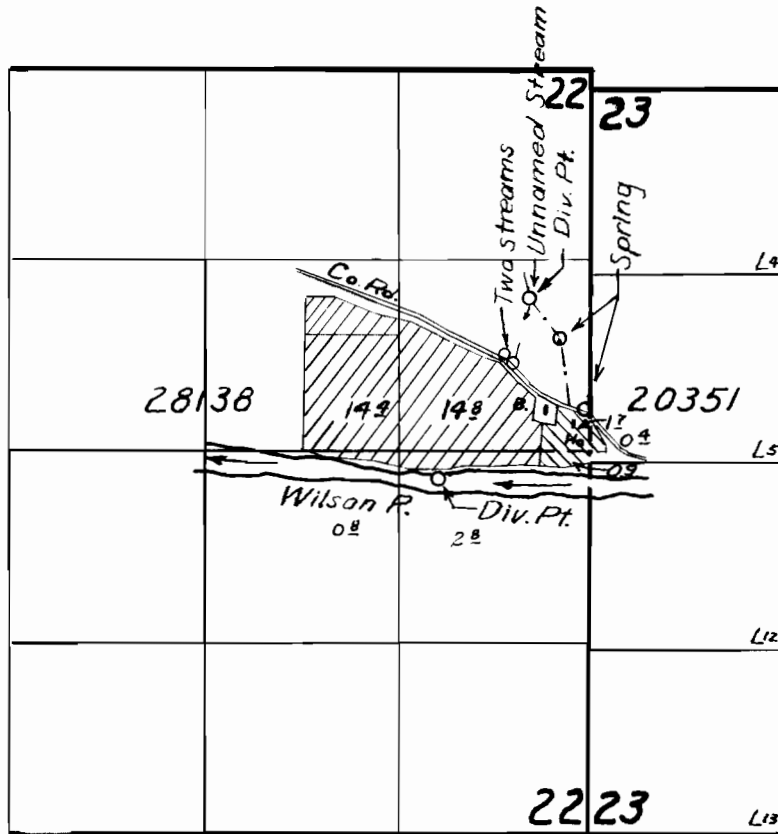

**FINAL PROOF SURVEY**

UNDER

20351

15874

Application No. 28138 Permit No. 22146

IN NAME OF

**LEO B. SANDER**

Surveyed July 14 1955, by *M. B. Sisk*