


19548  
21765  
21830

T.2S.R.25E.W.M.

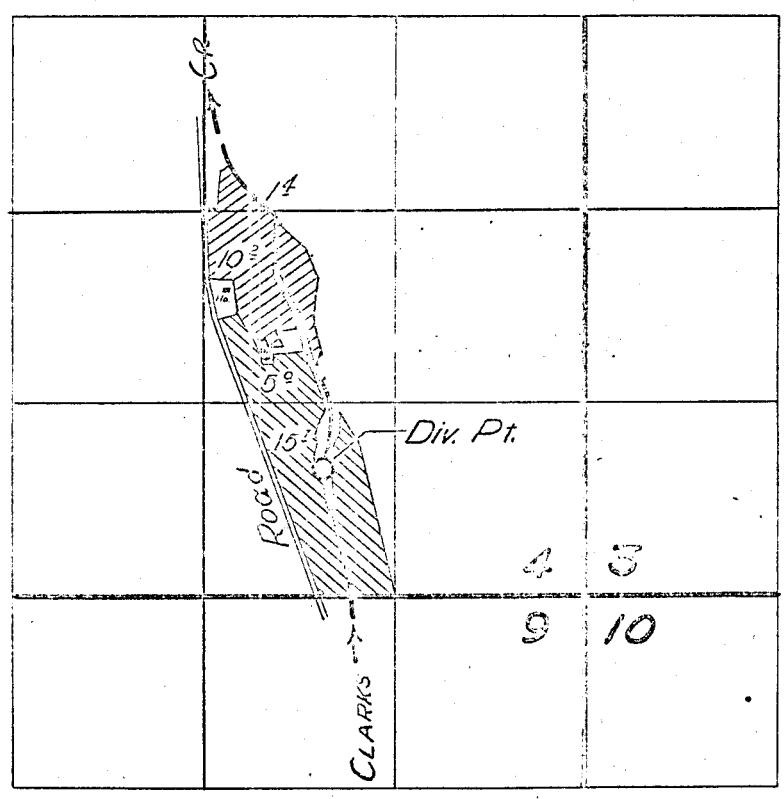

**FINAL PROOF SURVEY**

UNDER

24825

19548

Application No. 28172

Permit No. 22170

IN NAME OF

**EMMA R. PECK**

Surveyed 15 Apr. 1955, by T. JONES

1955-Z