


T.2S. R.9W.WM

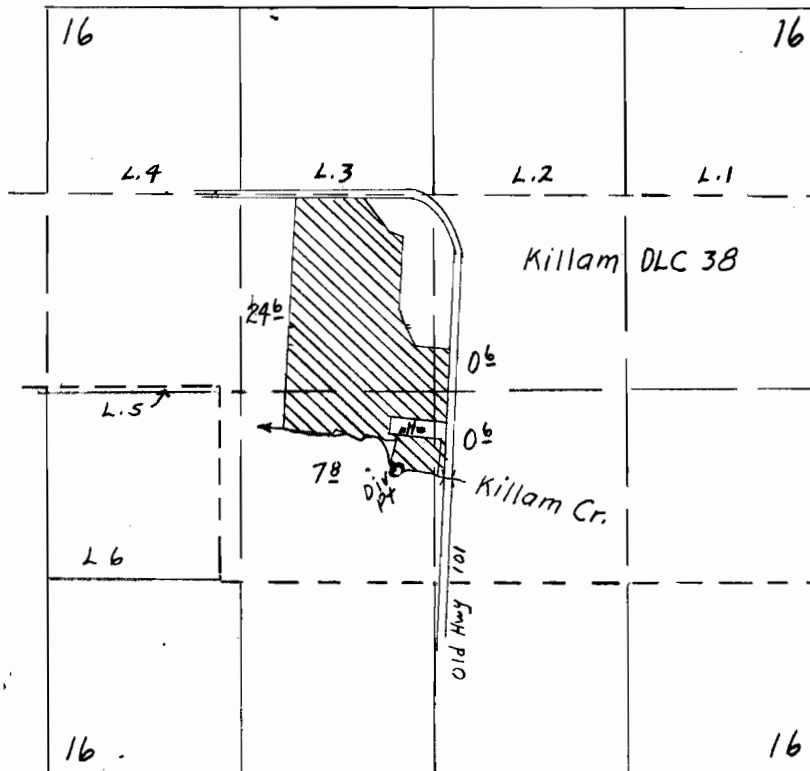

FINAL PROOF SURVEY

Under

Application 28274      Permit 22230

In name of

Bert H. Quick

Surveyed Sept 9, 1956 by R.H. Whitby