


T1E2SR9WWM

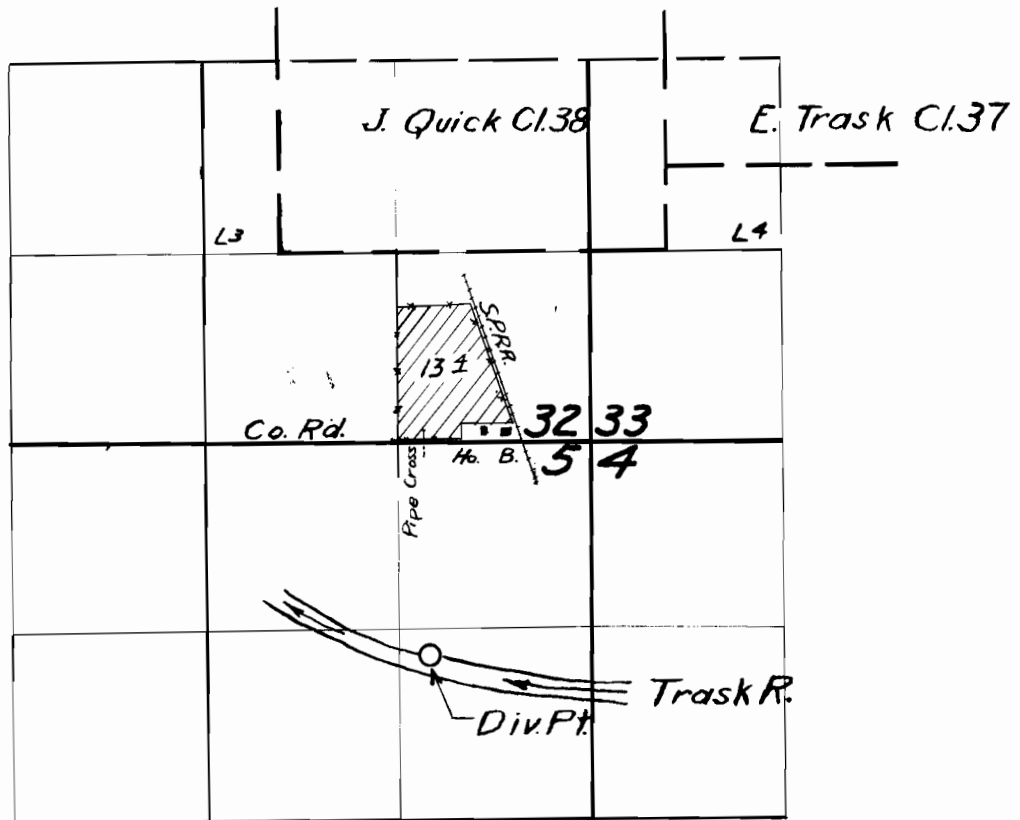

FINAL PROOF SURVEY

UNDER

Application No. 28340 Permit No. 22369

IN NAME OF

HANS LEWTHOLD

Surveyed July 22 1955, by *M. Bish*