


T. 26 S., R. 46 E. W.M.

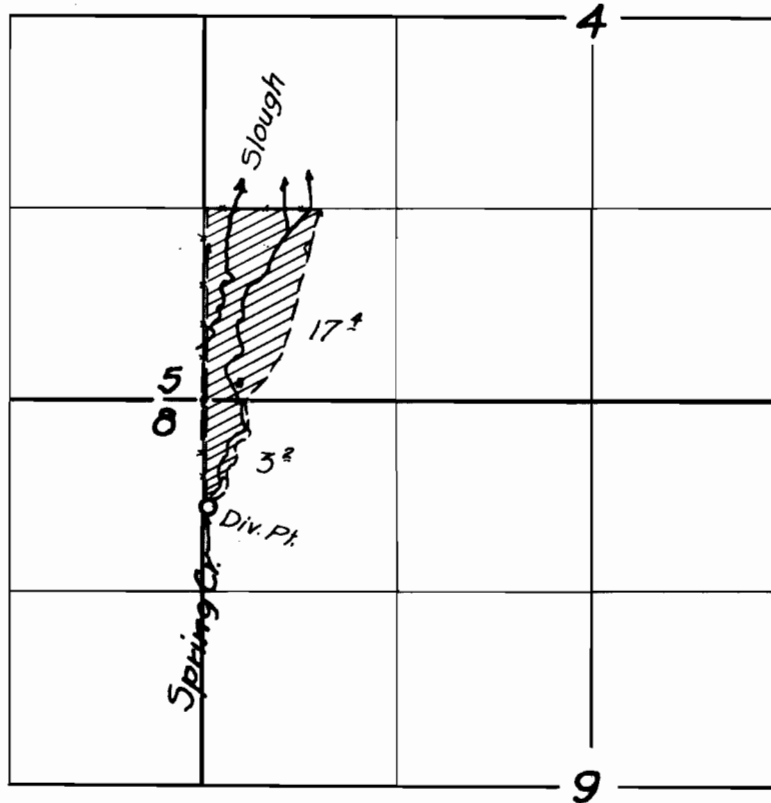

FINAL PROOF SURVEY

UNDER

Application No. 28569 Permit No. 22515

IN NAME OF

ANDREW GREELEY

Surveyed 8 November 1955, by Robert H. Reed