


T15R9WWM

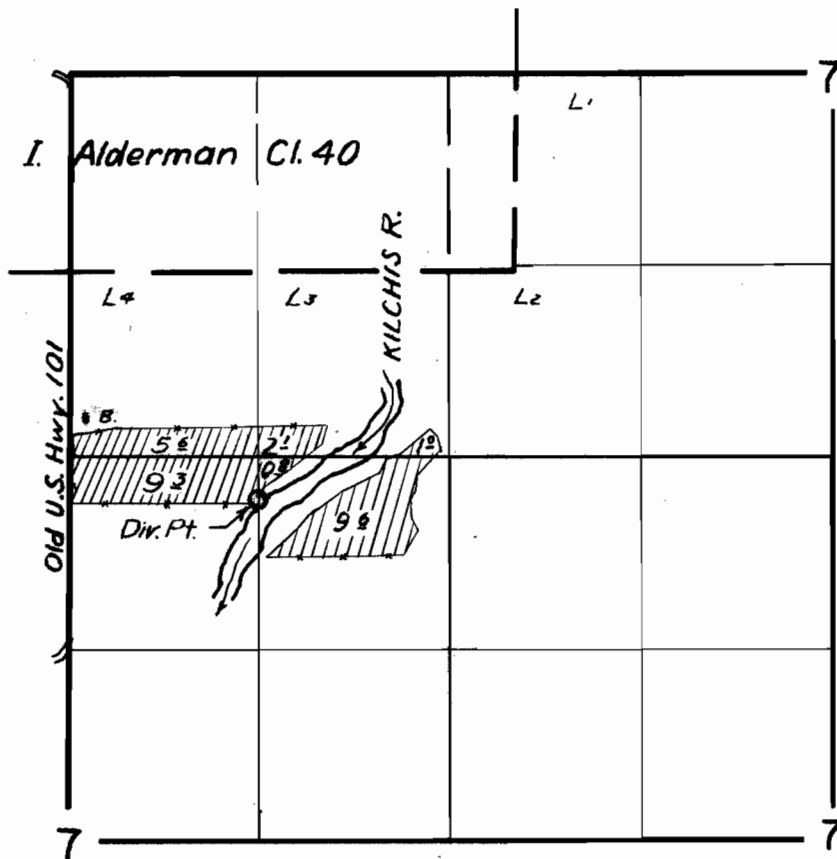

**FINAL PROOF SURVEY**  
UNDER

Application No. 29174. Permit No. 22940.  
IN NAME OF

**MILLARD BAILEY**

Surveyed July 7, 1955, by *M. B. Bish*