


T.5 S. R. 10 W. W.M.

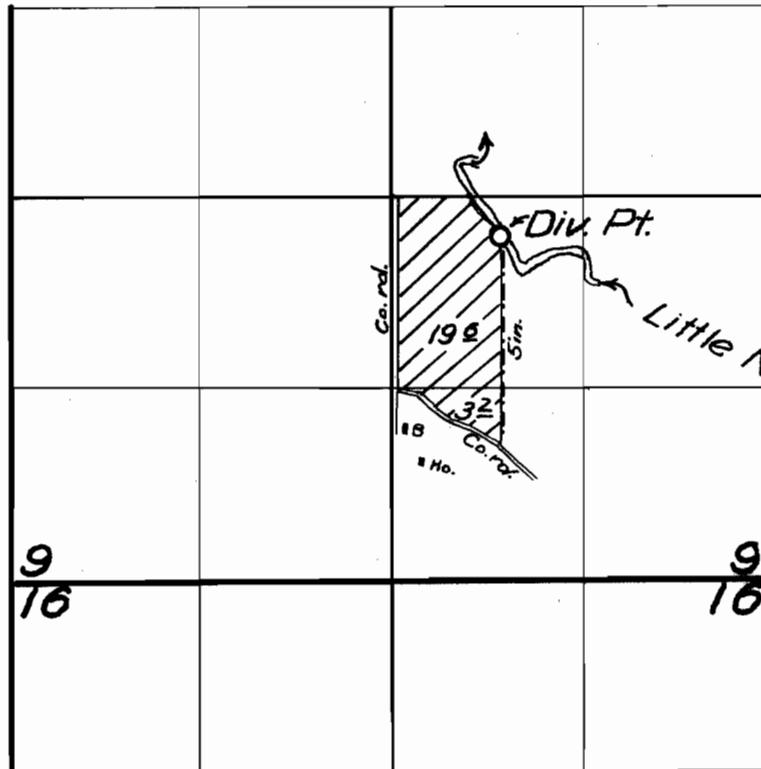

FINAL PROOF SURVEY
UNDER

Application No. 29181 Permit No. 22992
IN NAME OF

TONY HURLIMAN

Surveyed Sept 23 1955 by Tm. Bish

1955N