
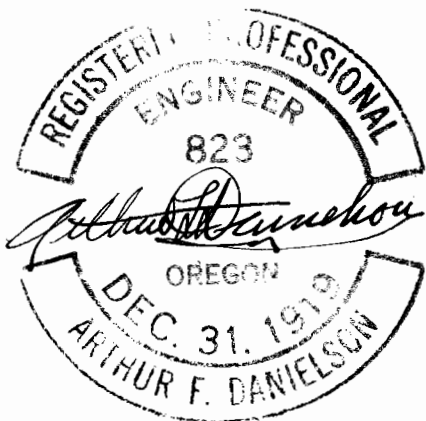


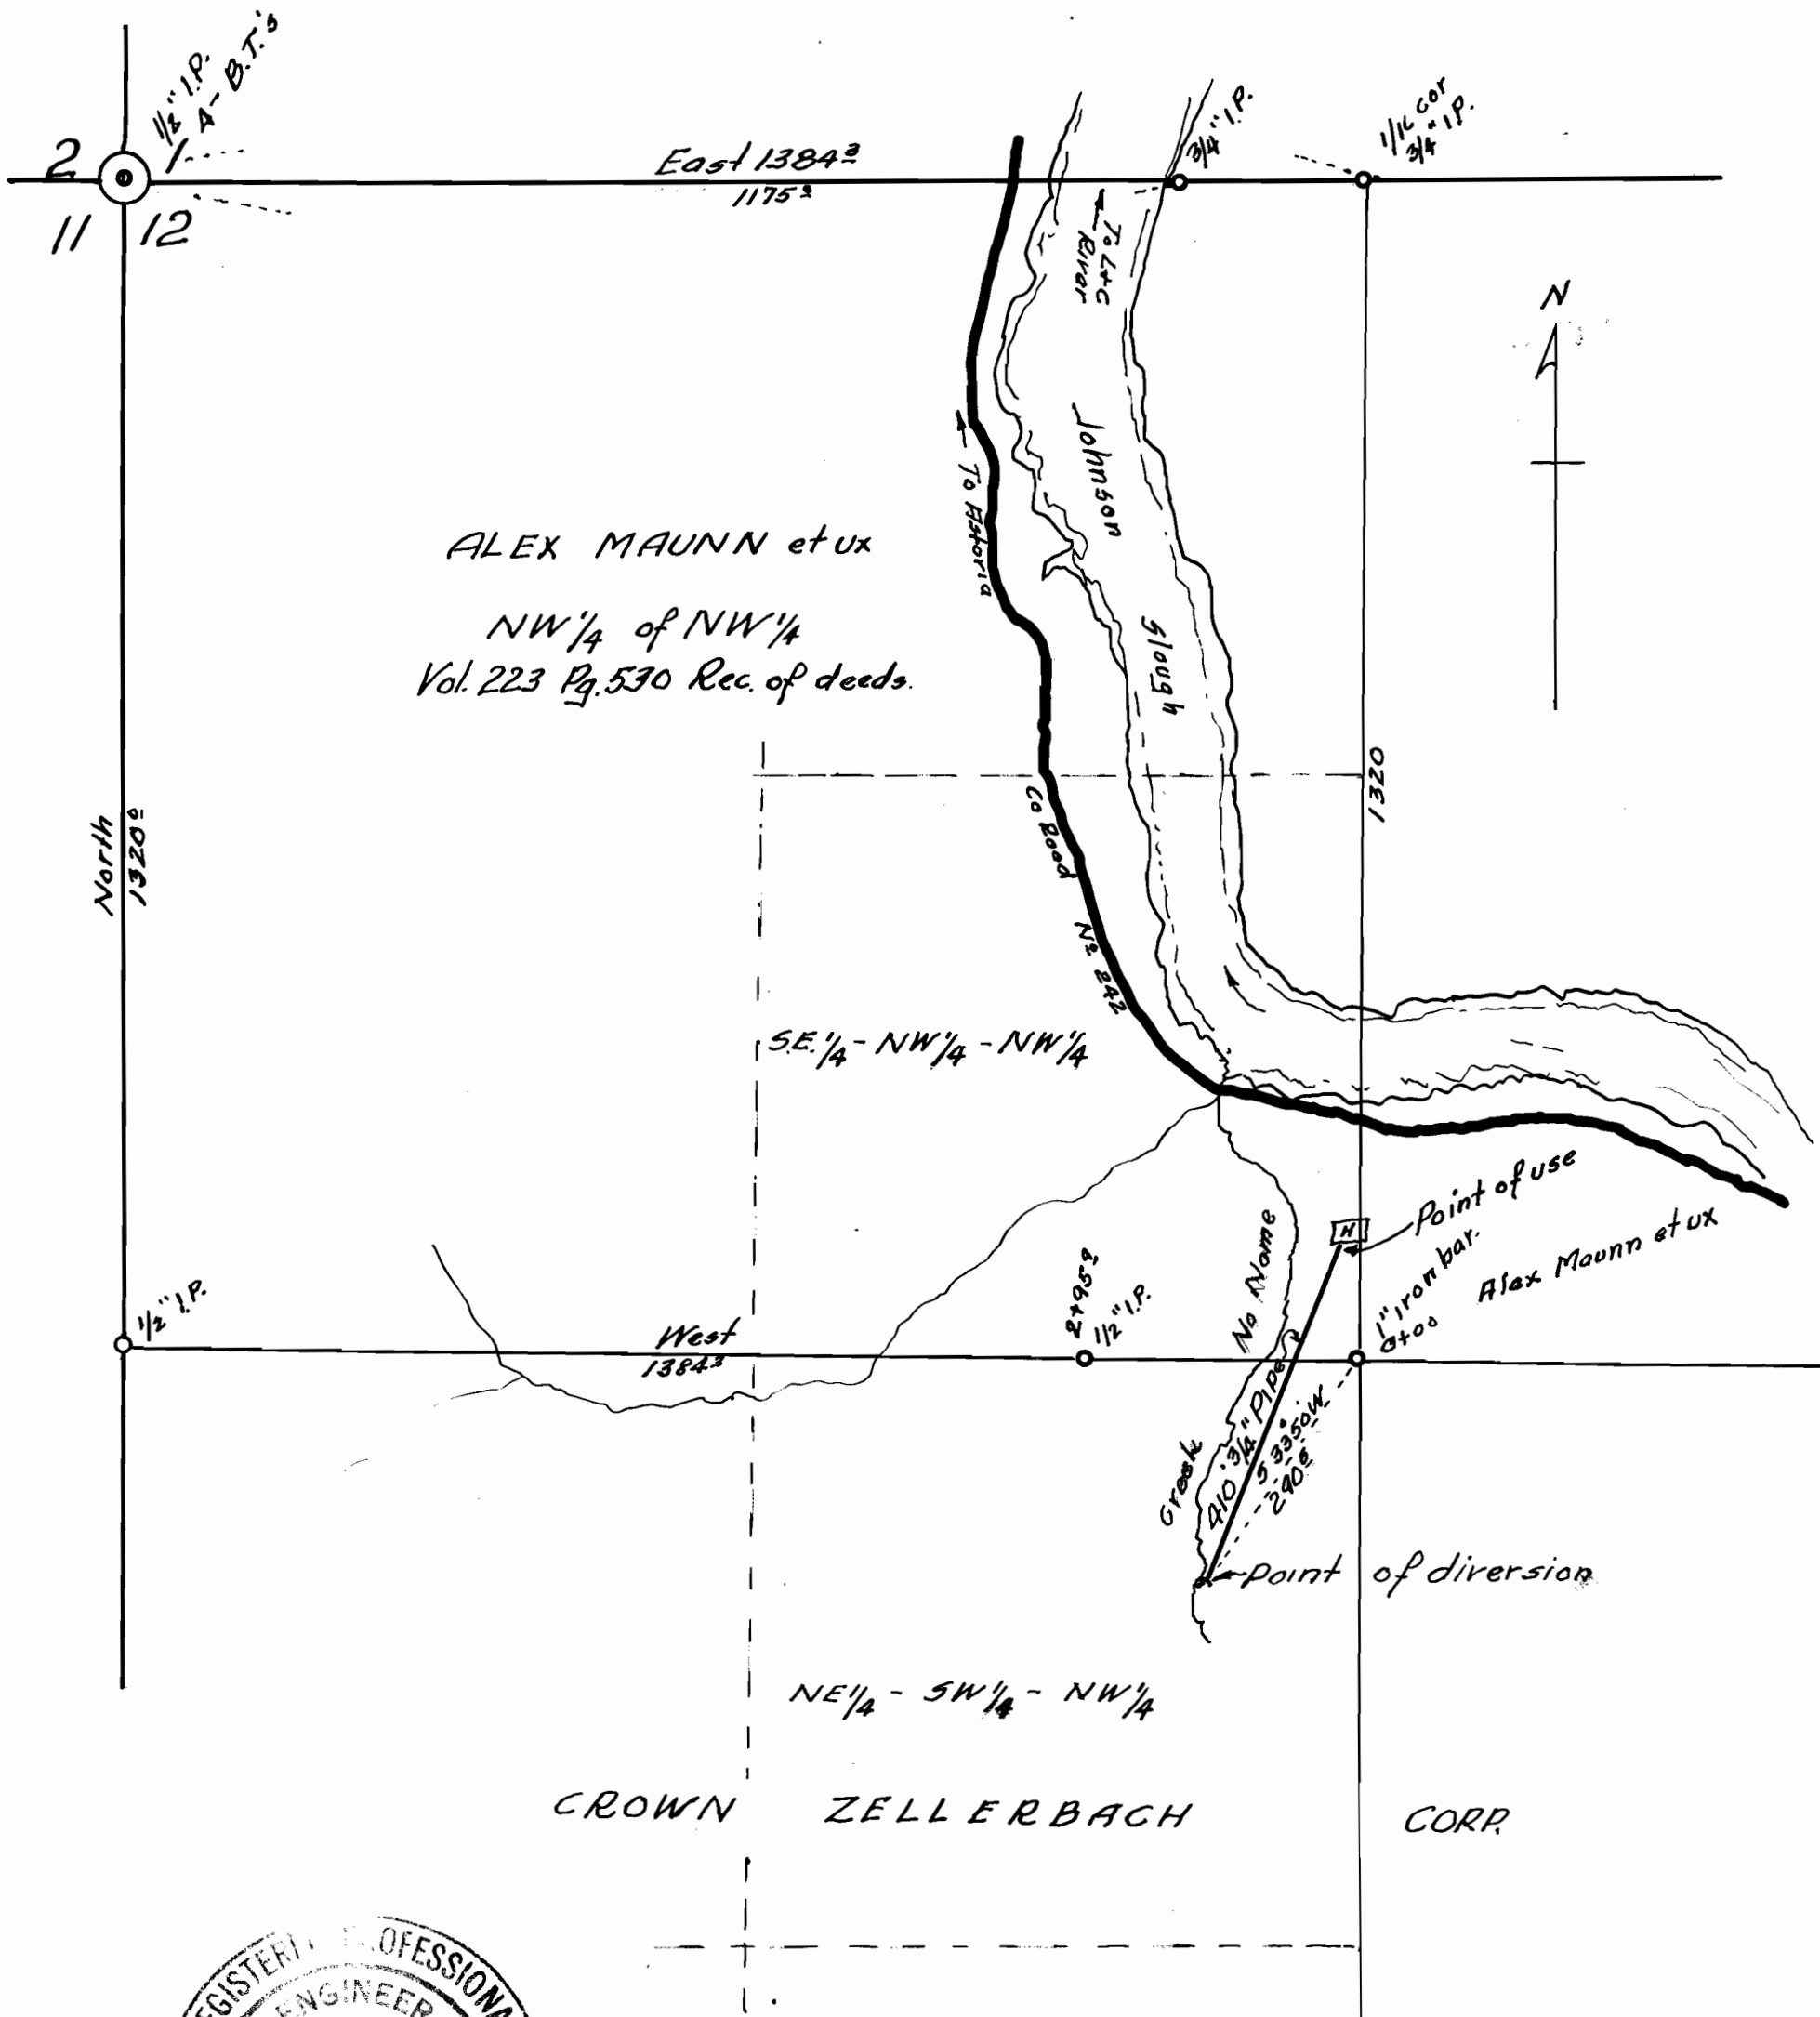

APPLICATION OF
ALEX MAUNN
FOR
Domestic Water Right

Application No 29703
Permit No. 23385

Sec. 12 T 7 N R 10 W W M
A. F. Danielson Co. Sur.

Jan. 1955.
Scale 1" = 200'