T. 4S R 3W. WM

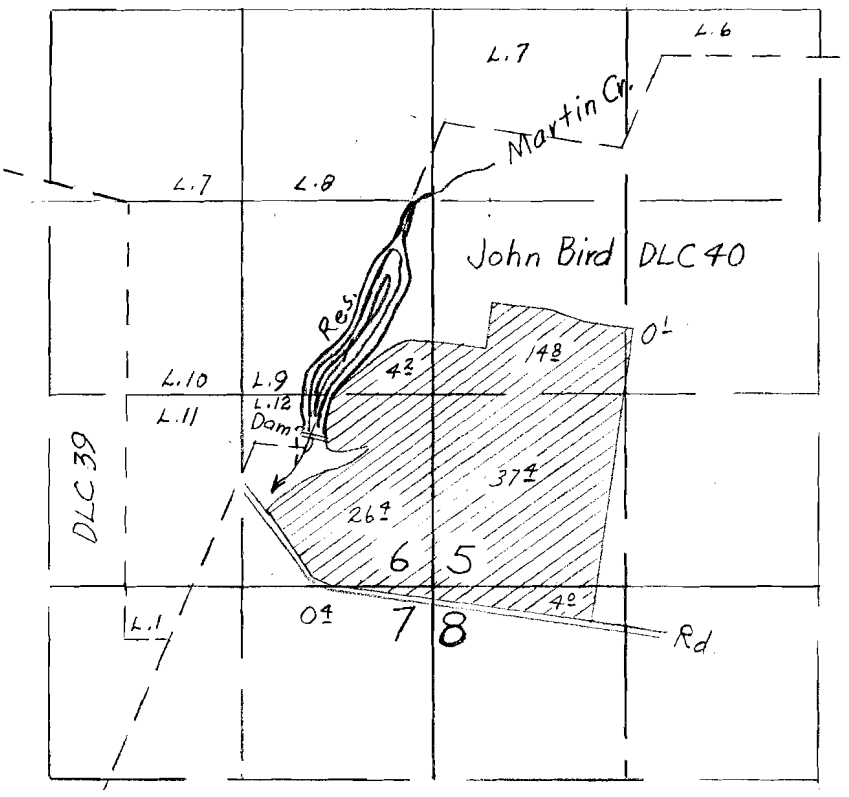

FINAL PROOF SURVEY

UNDER

Application No. R-23834 23835 Permit No. R-1008 19129

IN NAME OF

C.W. Kunz

Surveyed June 1 1955, by T. Jones

DFQ-3D-166