


T. 4S R. 3W. WM

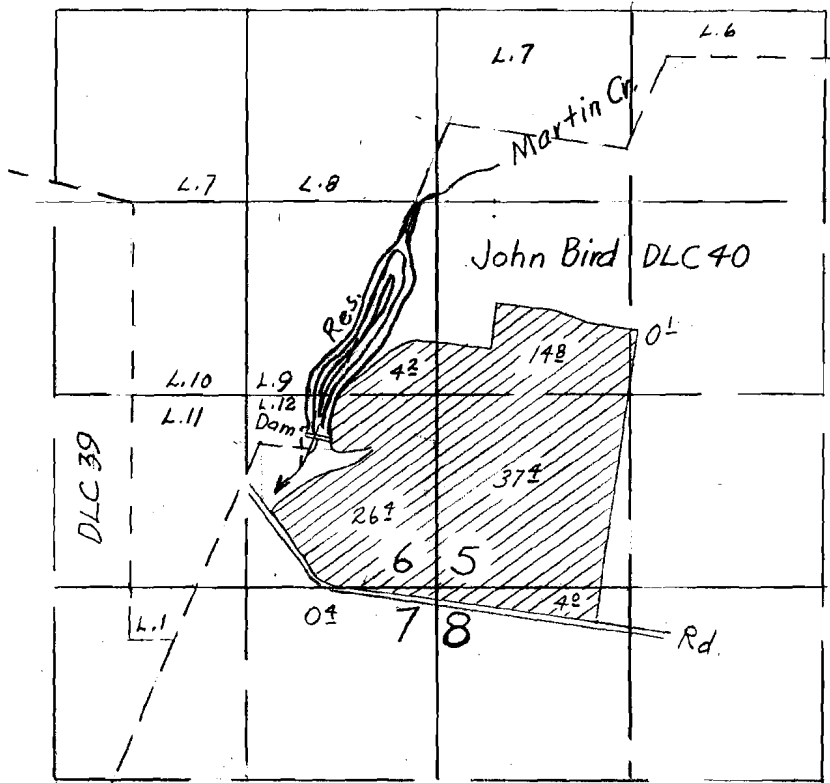

FINAL PROOF SURVEY

UNDER

R-23834

R-1008

Application No. 23835 Permit No. 19179

IN NAME OF

C.W. Kunz

Surveyed June 1, 1955, by T. Jones