


T. 26 S., R. 42 E. W.M

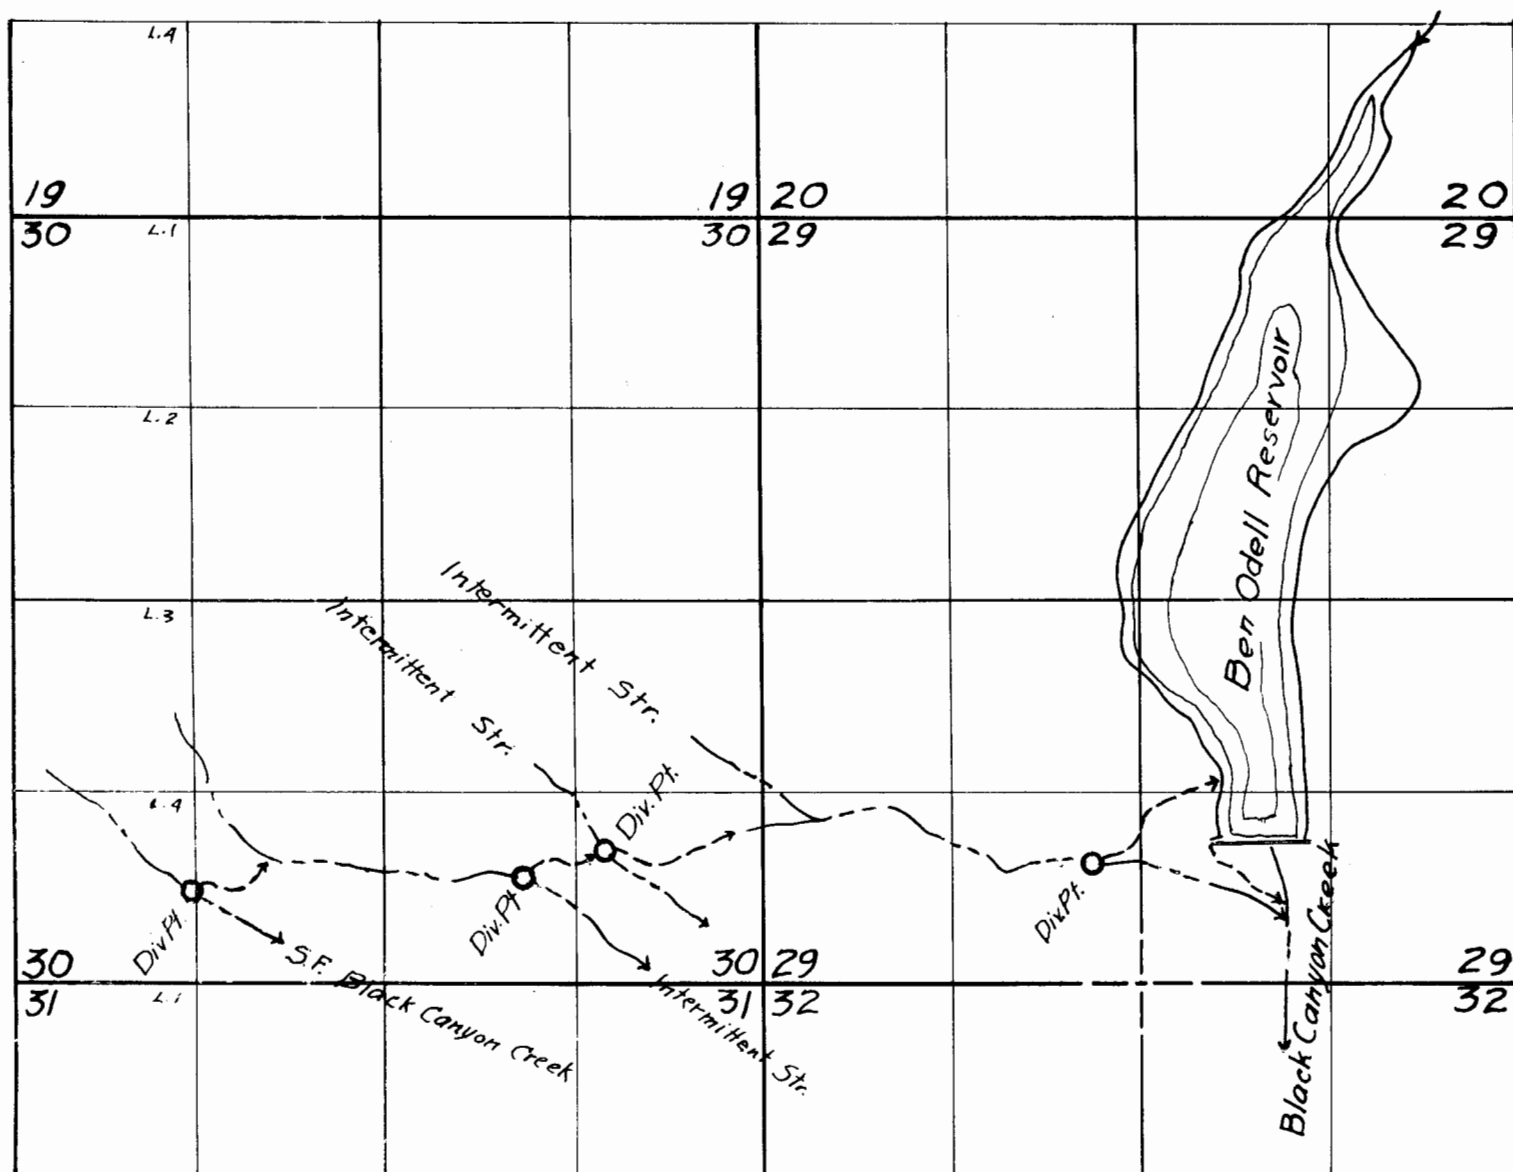

FINAL PROOF SURVEY
UNDER

APPLICATION NO. R27732&27733 PERMIT NO. R1549&22556

IN NAME OF
H. T. MARCOM

SURVEYED 5 NOVEMBER 1955 BY Robert A. Buck

1955U