


T. 17S. R. 22E. WM

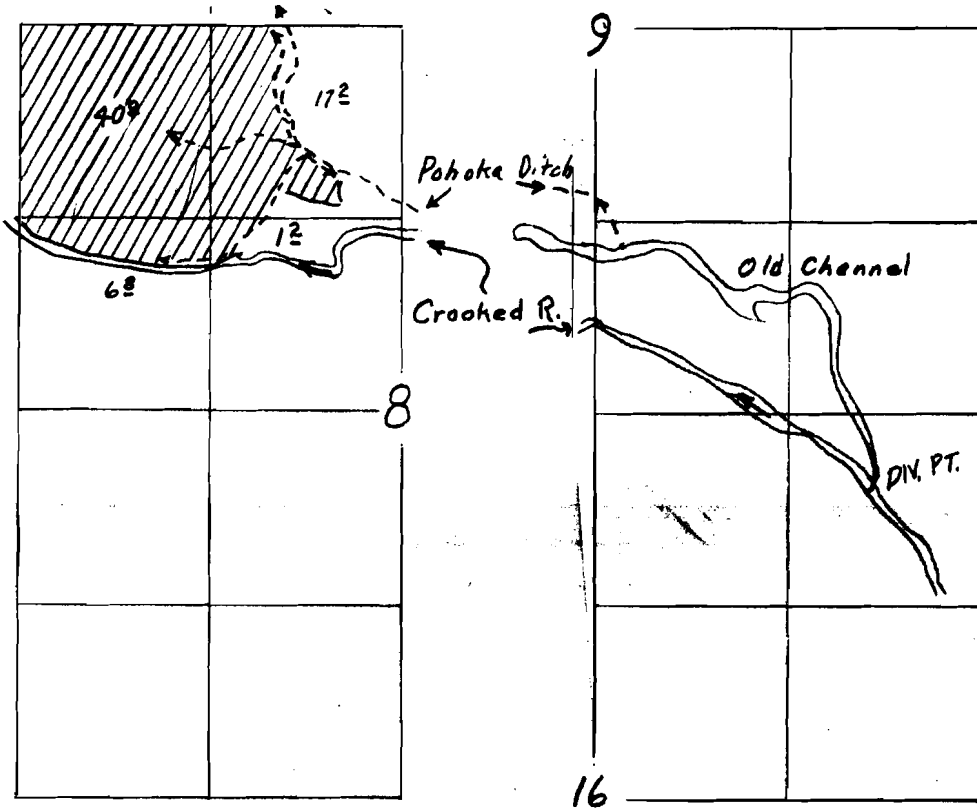

FINAL PROOF SURVEY

UNDER

Application No. 13941 Permit No. 10028

IN NAME OF

Mary Glenn Butler

Surveyed Apr. 24 1955, by T. Jones

C-21860

DCY-13H-140

10028