
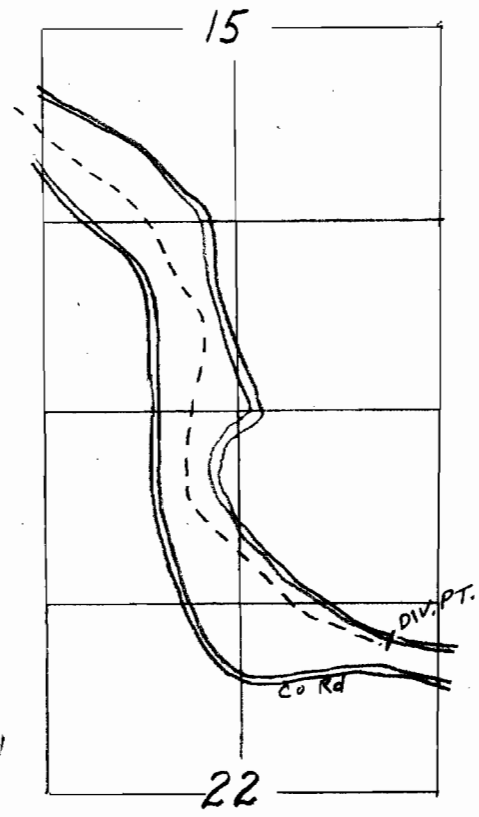


T. 17S. R. 21 & 22E WM

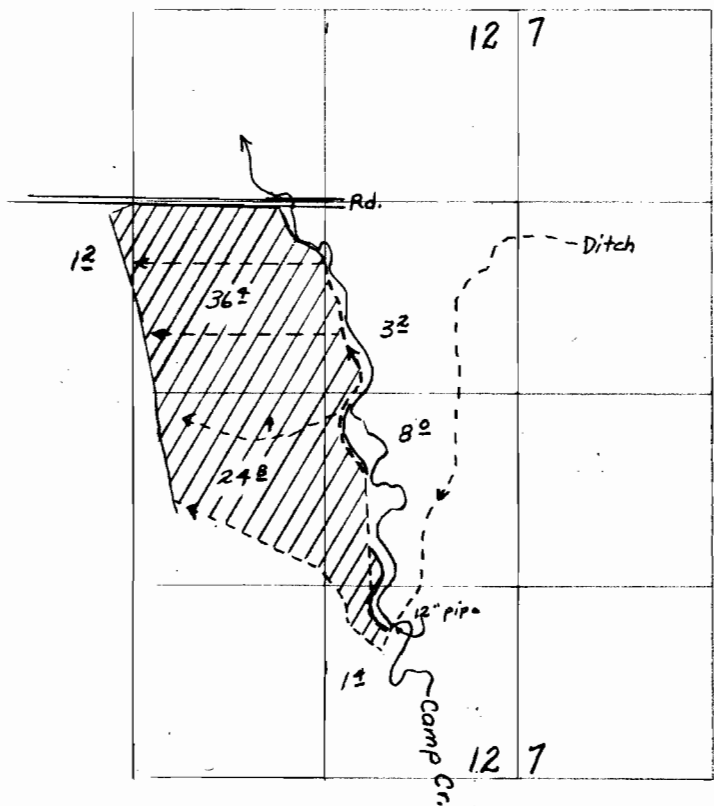

FINAL PROOF SURVEY

UNDER

Application No. 14506 Permit No. 10511

IN NAME OF

Mary Glenn Butler

Surveyed Apr 24 1955, by T. Jones