


T.40 S., R. 19 & 20 E. W. M.

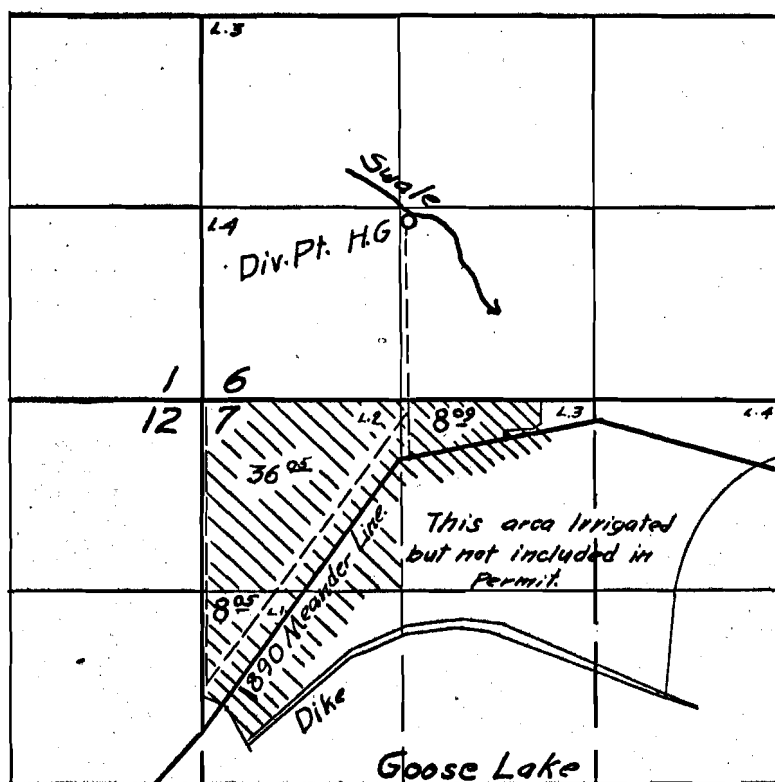

FINAL PROOF SURVEY UNDER

Application No. 16798.... Permit No. 12570...
IN NAME OF

A. E. GARRETT

Surveyed 5. October 19.55, by Robert H. Phund

40-19,20✓

CHZ-38K-127