


T. 7 S. R. 19 E. W.M.

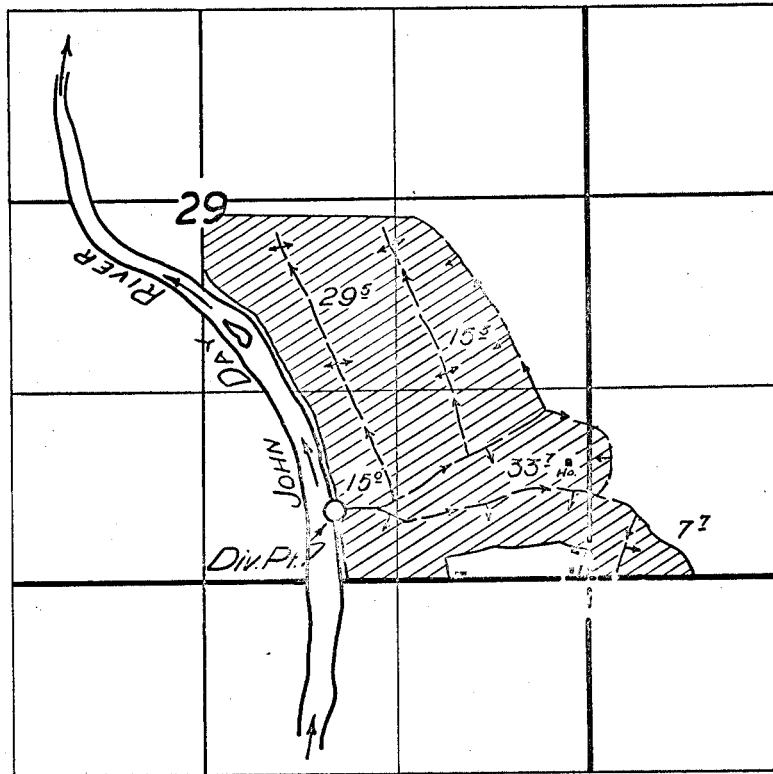

FINAL PROOF SURVEY
UNDER

Application No. 17205 Permit No. 12928
IN NAME OF

EMIL A. MAURER

Surveyed 18 Apr. 1955, by T. JONES

CCJ-5F-3