


T. 11 S., R. 8 W. W. M.

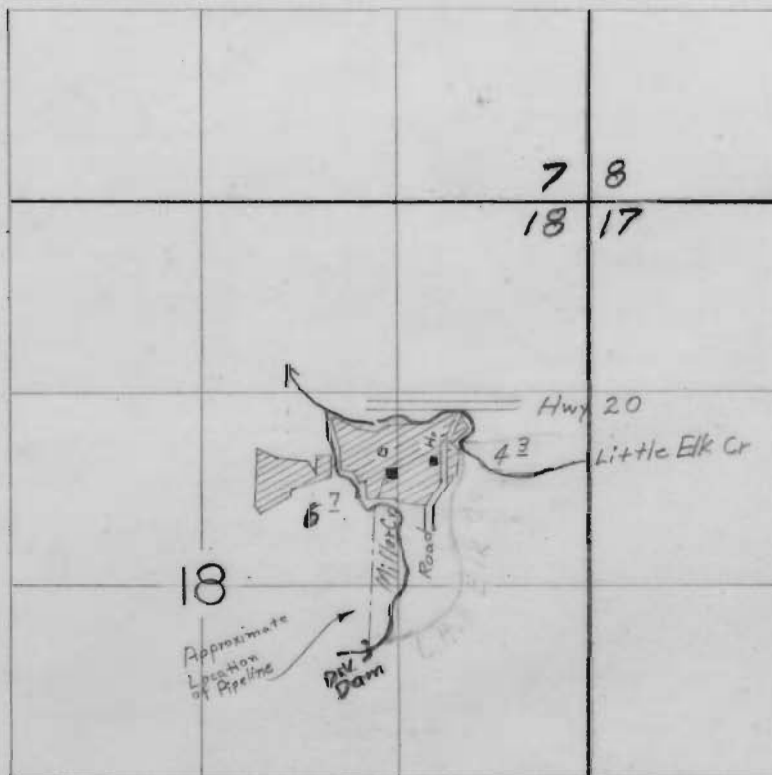

FINAL PROOF SURVEY
UNDER

Application No. 17531 Permit No. 13236
IN NAME OF

JERRY LAISURE

Surveyed 23 April, 1955, by H.L. Coffman