


T. 135, R. 10W, W.M.

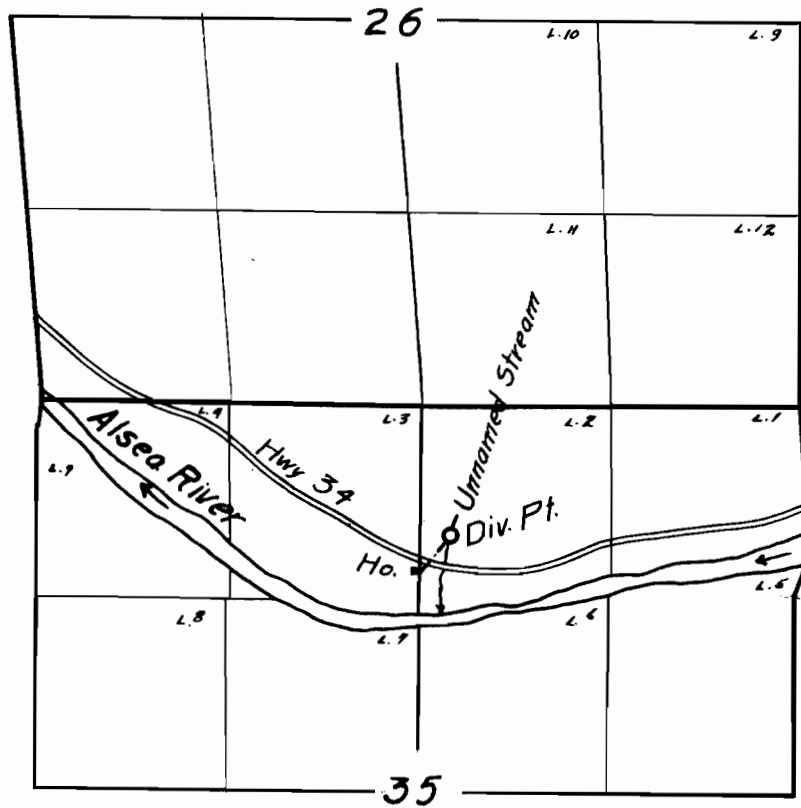

FINAL PROOF SURVEY
UNDER

Application No. 18767... Permit No. 14416.....
IN NAME OF

William L. & Velma Kelly

Surveyed 31 August, 1955, by Robert H. Burt