


T. 30S, R. 15W. W.M.

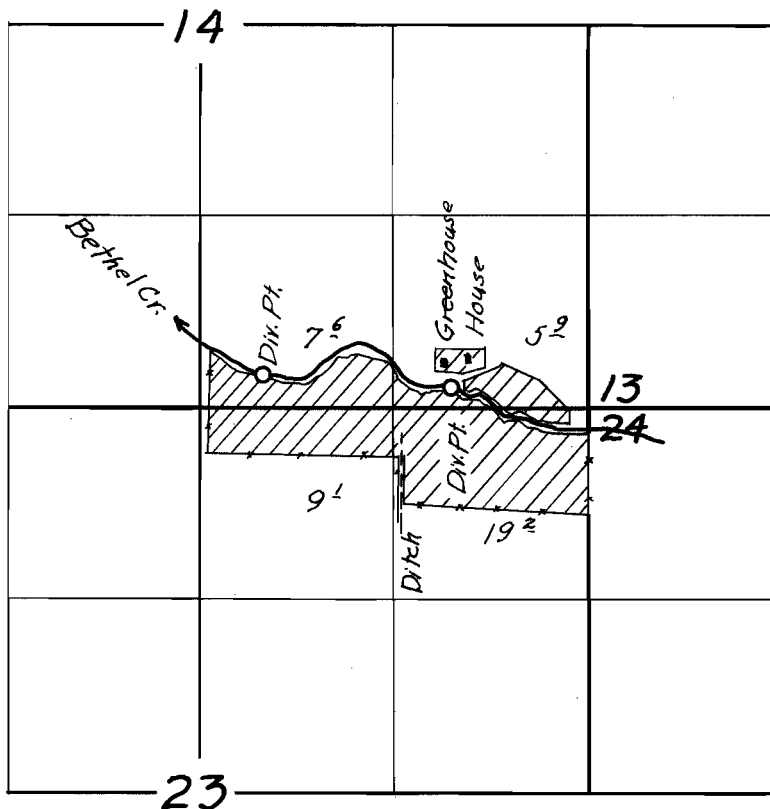

**FINAL PROOF SURVEY**

UNDER

Application No. 18973 Permit No. 14598

IN NAME OF

C.R. Sydman

Surveyed 9 March 1955, by H.L. Coffman