


T. 4 S. R. 3 W. W. M.

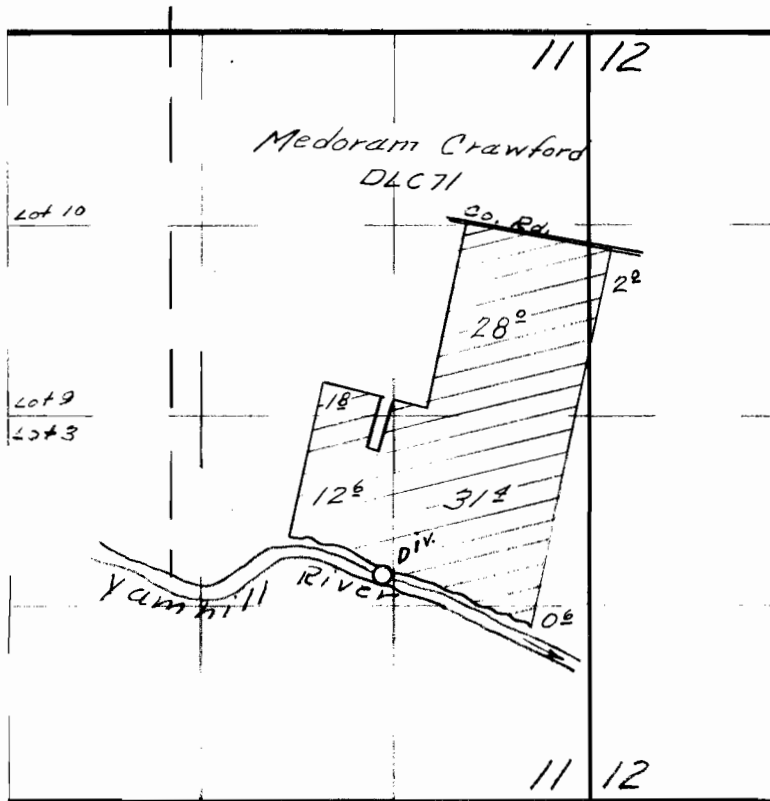

FINAL PROOF SURVEY  
UNDER

Application No. 18996 Permit No. 14611  
IN NAME OF

ELZIE G. KILGORE

Surveyed 20 Sept. 1955 by R. H. Whitby.

DFQ-2D-149