


T. 5 N., R. 36 E., W.M.

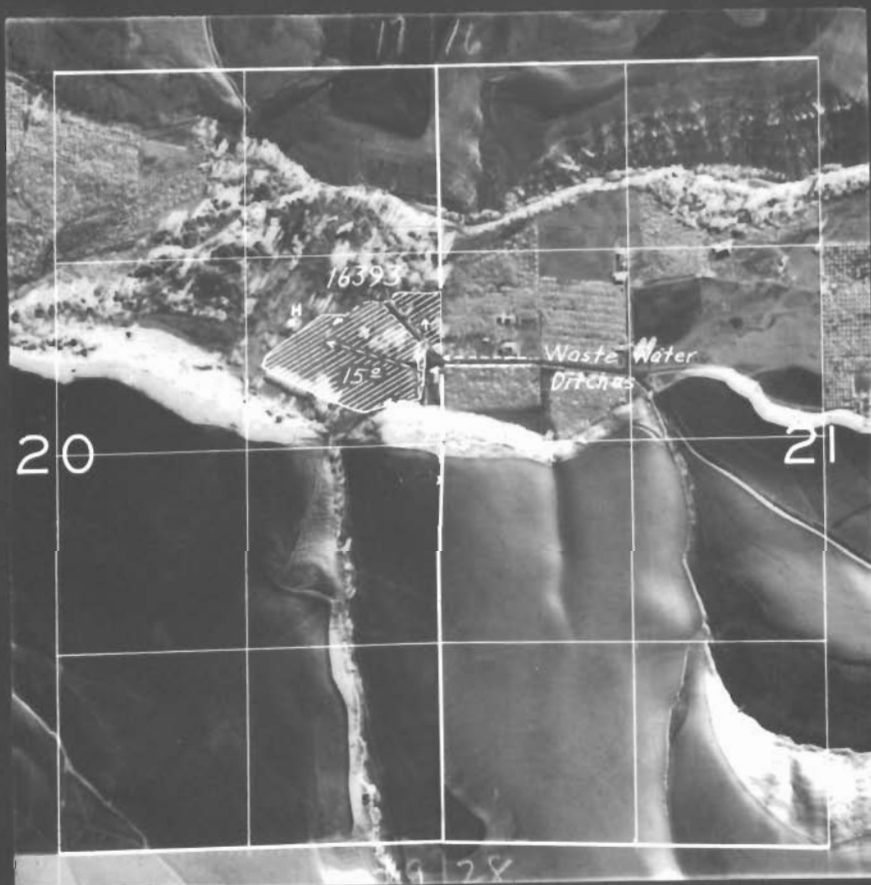

FINAL PROOF SURVEY
UNDER

Application No. 16393 Permit No. 12462
IN NAME OF

Laura Harris

Surveyed May 17 19 54, by T. Jones

NE-4E-150