


T. 10 S. R. 12 & 13 E. W. W.

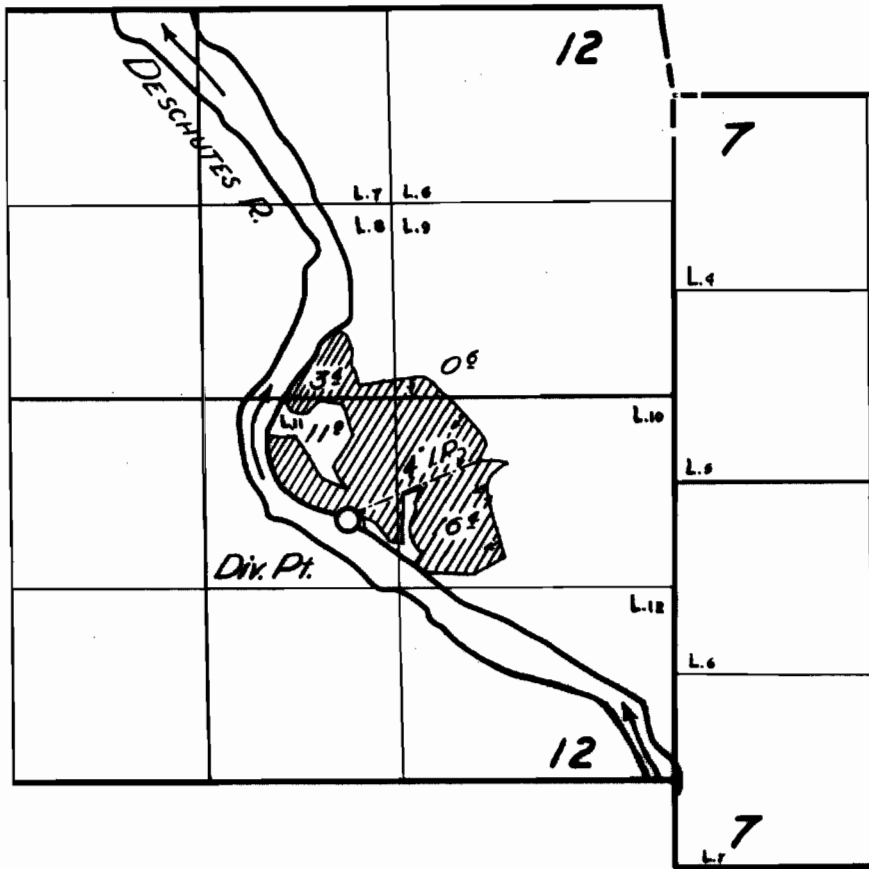

**FINAL PROOF SURVEY**

UNDER

Application No. 19127 Permit No. 14728

IN NAME OF

Glen DeShazer

Surveyed 3 Oct. 1955, by [Signature]