


T.41 S. R. 19 E. W. M.

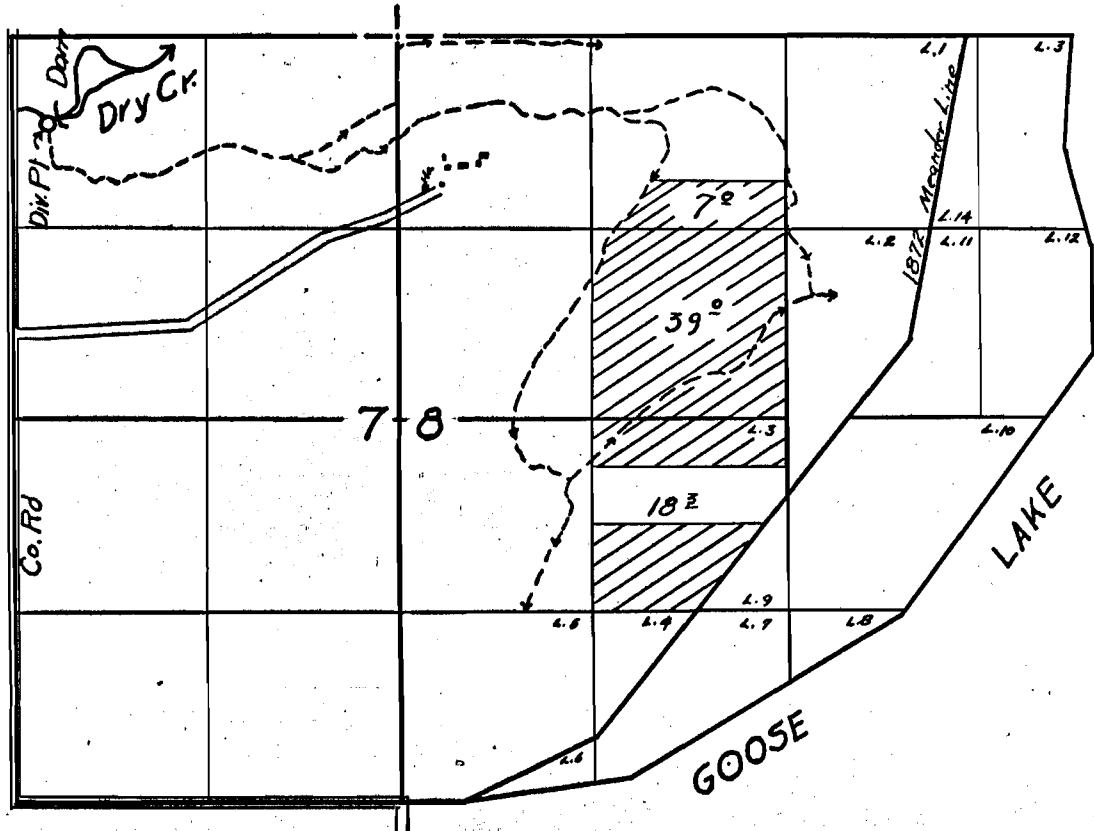

FINAL PROOF SURVEY
 UNDER

Application No. 19553 Permit No. 15136
 IN NAME OF

ARCHIE E. ANDERSON

Surveyed 4 October 1955, by [Signature]