


T. 2 N., R. 5 W., W.M.

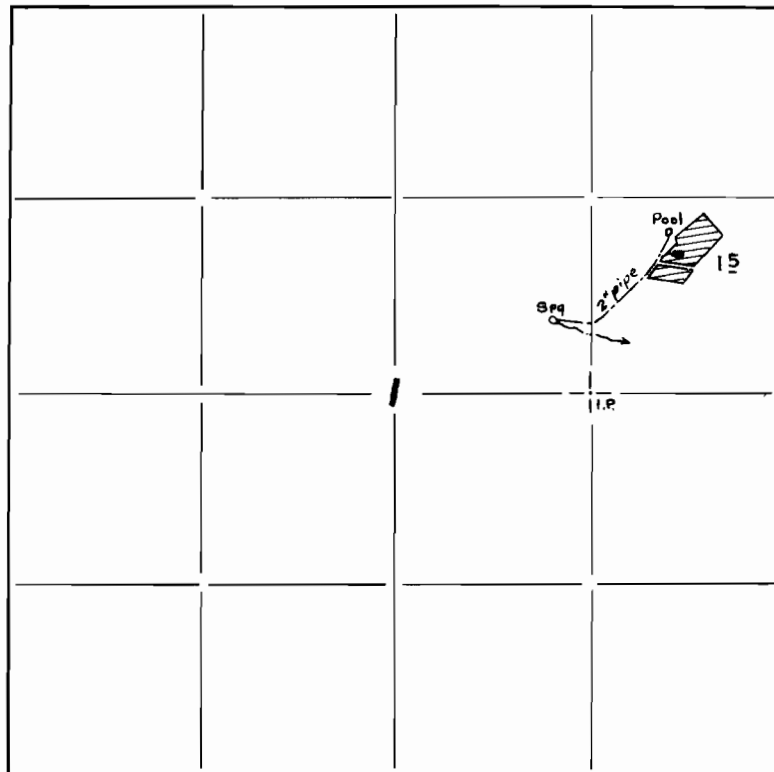

FINAL PROOF SURVEY

UNDER

Application No. 19463 Permit No. 15171

IN NAME OF

Fred A. Fritz

Surveyed July 12 1956, by Geo V. Naderman