


T.13S. R.10W. W.M.

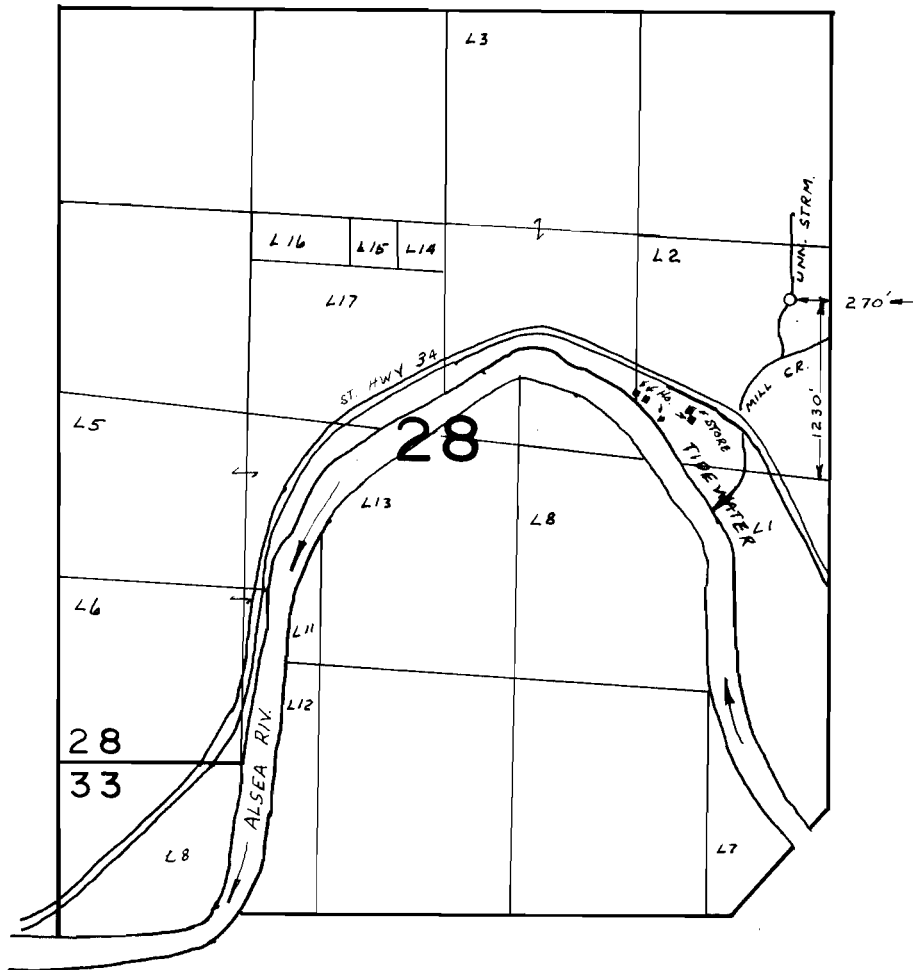

FINAL PROOF SURVEY
UNDER

Application No. 42021 Permit No. 31446
IN NAME OF

LEE E. WELTNER

Surveyed JUN 6 1974, by L H NUNN