


T.3S.R.10W.W.M.

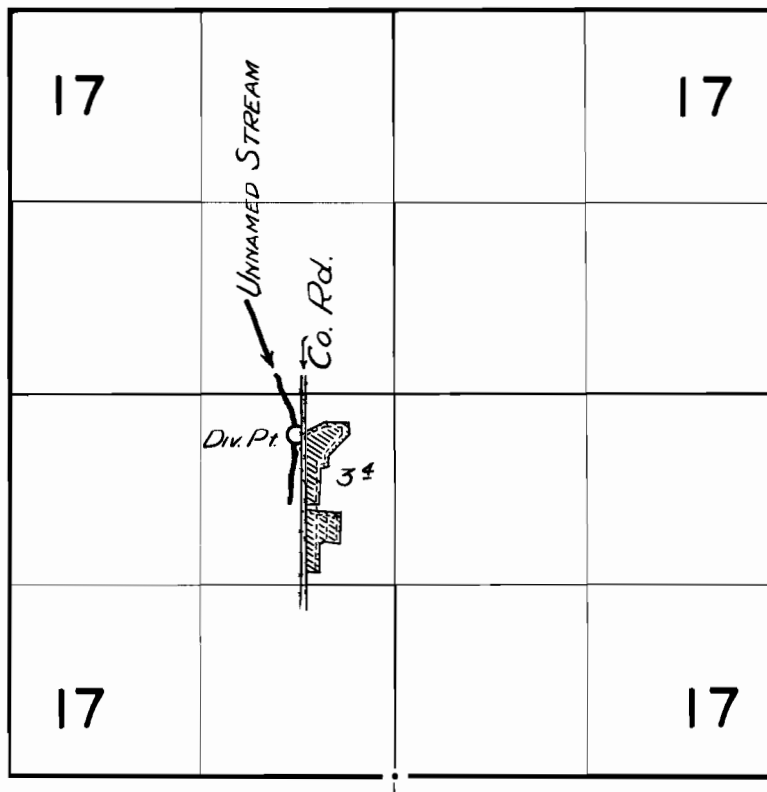

FINAL PROOF SURVEY

UNDER

Application No 20942 Permit No 16399

IN NAME OF

CLAY MYERS

Surveyed 23 Aug 1955, by *R. H. Whitby*