


T.12S.R.9E.W.M.

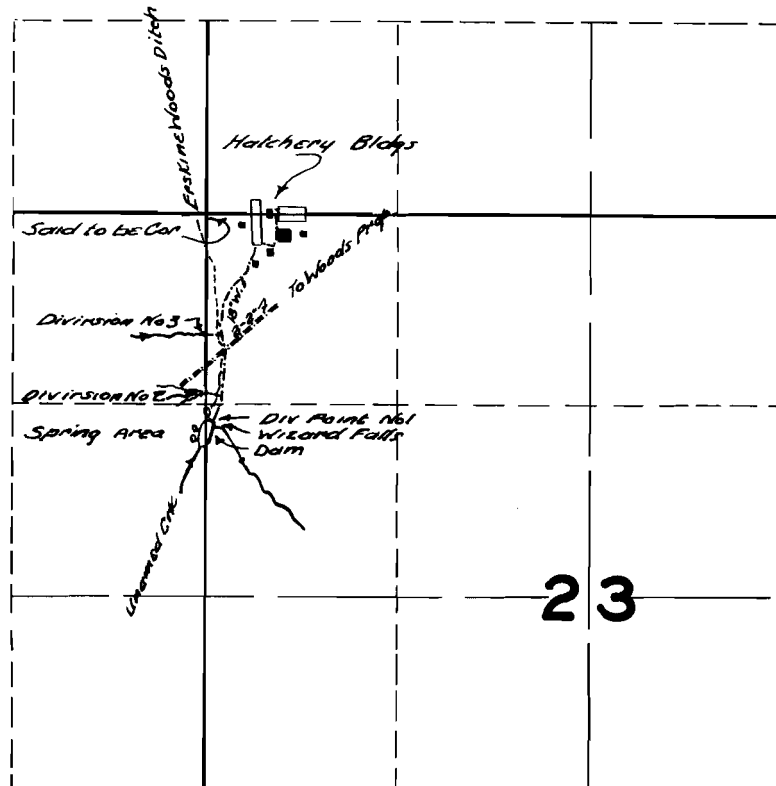

FINAL PROOF SURVEY

UNDER

Application No. 20412 Permit No. 15940

IN NAME OF

OREGON STATE GAME COMMISSION

Surveyed SEPT. 28 1949, by H.L. COFFMAN