


T. 4S. R. 9W.W.M.

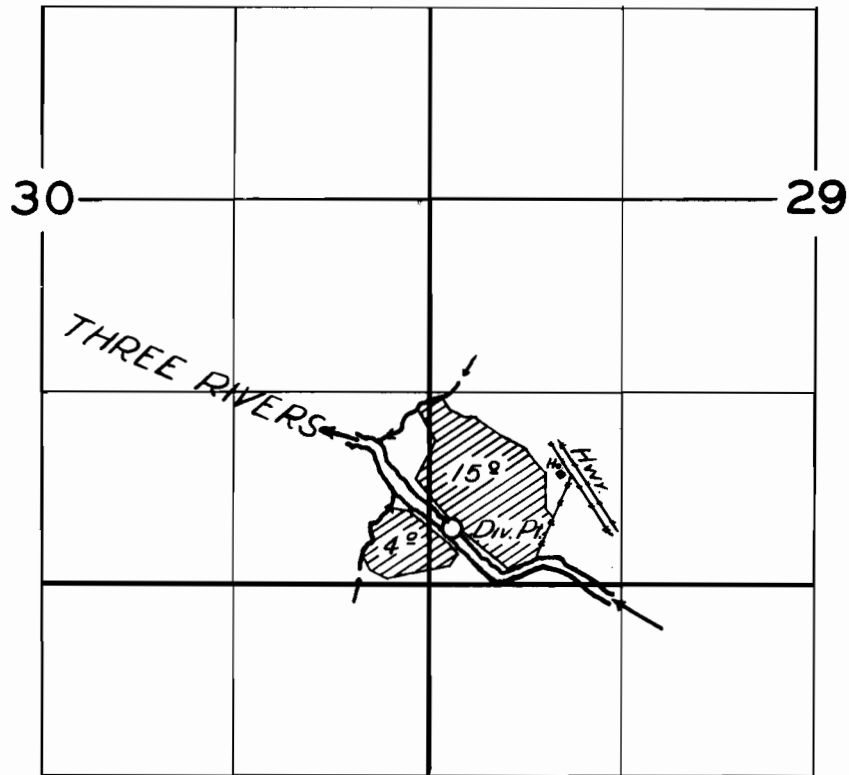

FINAL PROOF SURVEY

UNDER

Application No. 20512 Permit No. 16014

IN NAME OF

GEORGE C. ABERNATHY

Surveyed / Sep. 1955, by R. A. Whitby

1955-E